



AECOM
500 W Jefferson St.
Suite 1600
Louisville, KY 40202
www.aecom.com

502-569-2301 tel
502-569-2304 fax

October 17, 2018

Big Rivers Electric Corporation
Sebree Generating Station
9000 Highway 2096
Robards, Kentucky 42452

**Engineer's Certification of Placement Above the Uppermost Aquifer
Existing Green CCR Surface Impoundment
EPA Final CCR Rule
Sebree Station
Robards, Kentucky**

1.0 PURPOSE

The purpose of this document is to certify that the Placement above Sebree "Green" Existing CCR Surface Impoundment is in compliance with the Placement above the Uppermost Aquifer requirement of the Final CCR Rule at 40 CFR §257.60. Presented below is the project background, summary of findings, limitations and certification.

2.0 BACKGROUND

In accordance with 40 CFR §257.60, the owner/operator of an existing CCR Surface Impoundment must demonstrate that the base of the unit is located no less than 1.52 meters (five feet) above the upper limit of the uppermost aquifer, or must demonstrate that there will not be an intermittent, recurring, or sustained hydraulic connection between any portion of the base of the CCR unit and the uppermost aquifer due to normal fluctuations in groundwater elevations (including the seasonal high water table). In accordance with 40 CFR §257.60(c)(1), the demonstration must be made by October 17, 2018. If such demonstration cannot be made, the unit is subject to the closure or retrofit requirements of 40 CFR §257.101

3.0 SUMMARY OF FINDINGS

Available data regarding site groundwater, site geology, and physical limits of the unit for the Green Surface Impoundment do not evidence a 5-foot separation between the base of the impoundment and the uppermost limit of the uppermost aquifer and they do not support a lack of hydraulic connectivity between the unit and the aquifer as specified in 40 CFR §257.60(a). Therefore the unit does not meet the Placement above the Uppermost Aquifer requirement of 40 CFR §257.60(a).



4.0 CERTIFICATION

I, Michael Brian Cole, being a Registered Professional Engineer in good standing in the State of Kentucky, do hereby certify, to the best of my knowledge, information, and belief, that the information contained in this certification has been prepared in accordance with the accepted practice of engineering. I certify, for the above-referenced CCR Unit, available data do not support a demonstration of Placement above the Uppermost Aquifer that meets the requirements of 40 CFR § 257.60(a).

M. Brian Cole
Printed Name

October 17, 2018
Date



ADDRESS: AECOM
500 W Jefferson St Suite 1600
Louisville, KY 40202

TELEPHONE: (502)-569-2301

ATTACHMENTS: Placement above the Uppermost Aquifer Demonstration for Coal Combustion
Residuals



Your Touchstone Energy® Cooperative 

Existing Green CCR Surface Impoundment

**Disposal of Coal Combustion Residuals (CCR) from Electric
Utilities Final Rule**

**Placement above the Uppermost Aquifer Demonstration for
Coal Combustion Residuals (CCR)**

October 17, 2018

Prepared by

AECOM

Project Number: 60570534

TABLE OF CONTENTS

1.0	INTRODUCTION	1
1.1	Objective.....	1
1.2	Rule Requirements	1
1.3	Methodology/Background	1
1.4	Site Background.....	1
1.5	Site History	3
2.0	GEOLOGY	3
3.0	HYDROGEOLOGY	4
3.1	Groundwater Monitoring System.....	5
3.2	Groundwater Flow.....	5
4.0	UPPERMOST AQUIFER	7
4.1	Aquifer Characteristics.....	7
4.2	Placement Above the Uppermost Aquifer.....	7
5.0	CONCLUSIONS.....	8
6.0	REFERENCES	8

FIGURES

Figure 1. Site Location

Figure 2. Surface Impoundment Site Location

Figure 3. Surface Impoundment – Groundwater Contour Map – October 2017

ATTACHMENTS

Attachment A. Tables 1 and 2

Attachment B. Groundwater Elevation Summary

Attachment C. Boring Logs and Well Construction Diagrams

1.0 INTRODUCTION

1.1 Objective

The purpose of this demonstration is to document compliance with 40 Code of Federal Regulations (CFR) §257.60 of the Environmental Protection Agency Final Coal Combustion Residual Rule (EPA Final CCR Rule) regarding the Placement above the Uppermost Aquifer Demonstration requirement for the existing “Green” Surface Impoundment at the Big Rivers Electric Corporation (BREC) Sebree Station in Sebree, Kentucky.

1.2 Rule Requirements

As required by 40 CFR §257.60(a) of the EPA Final CCR Rule, any existing CCR Surface Impoundments must be constructed with a base that is located no less than 1.52 meters (5 feet) above the upper limit of the uppermost aquifer, or must demonstrate that there will not be an intermittent, recurring, or sustained hydraulic connection between any portion of the base of the CCR unit and the uppermost aquifer due to normal fluctuations in groundwater elevation. The “uppermost aquifer” is defined by 40 CFR §257.40 as the geologic formation nearest the natural ground surface that is an aquifer, as well as lower aquifers that are hydraulically interconnected with this aquifer within the facility’s property boundary. This definition includes a shallow, deep, perched, confined or unconfined aquifer, provided it yields usable water.

The demonstration is due by October 17, 2018 in accordance with 40 CFR §257.60(c)(1). Those Surface Impoundments that cannot demonstrate compliance with the requirement of 40 CFR §257.60(a) are required by 40 CFR §257.60(c)(4) to cease placement of CCR in the unit within 6 months (April 2019).

1.3 Methodology/Background

The demonstration method involves the use of existing documentation of pertinent geologic and hydrogeologic information to develop a conceptual site model (CSM) for the uppermost aquifer inclusive of the definition of its uppermost limit, normal fluctuations in groundwater elevation, and the potential for the aquifer’s hydraulic interconnection with overlying strata and the planned landfill limits. Existing documentation includes state and/or federal geologic maps and water resources publications, the logs of borings drilled on site for geotechnical purposes, the logs of monitoring wells installed on site and in surrounding areas, and design drawings for the unit.

1.4 Site Background

Big Rivers Electric Corporation (BREC) owns and operates the “Sebree” Station in Sebree, Kentucky. The Sebree Station is located in Webster County, approximately 3.2 miles northeast of the town of Sebree, Kentucky situated immediately east of the Pennyriple Parkway approximately 1.5 miles north of the intersection of the Pennyriple Parkway and Kentucky Route 56 (see Figure 1). Sebree Station is composed of 2 Green generating units, one Reid generating unit, and 2 HMP&L generating units. The Green Surface Impoundment is located directly south of the Sebree Station, situated north of the Green CCR Landfill. The current Green Surface Impoundment footprint is approximately 16 acres (Figure 2).

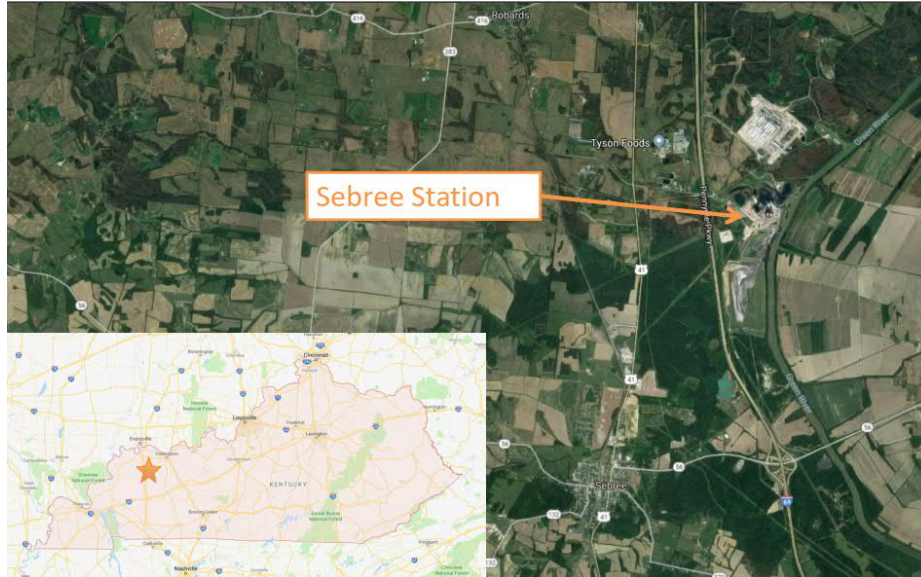


Figure 1: BREC Sebree Site Location

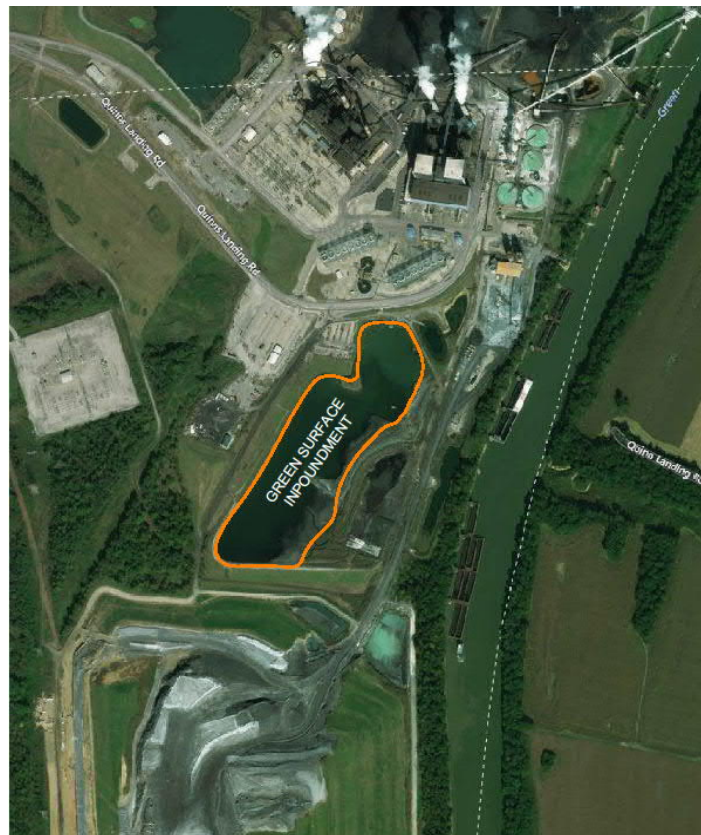


Figure 2: BREC Green Surface Impoundment Site Location

1.5 Site History

The Green Surface Impoundment is a combined incised/dike earthen embankment structure. It is diked on the west, south and east sides, while the north side is incised. The south dike has the greatest height reaching approximately 20 feet. The original ground surface within the Surface Impoundment footprint was irregular and the predominant features were small stream valleys draining eastward to Green River. Most of the central portion of the south dike was constructed on a subdued ridge. The toe of the outboard slope intersected a lower drainage area. Underlying preconstruction soils consisted of Loring-Grenada, Loring-Zanesville-Wellston (Henderson County) and Loring-Wellston-Zanesville (Webster County) soil associations that are generally characterized as well drained to moderately well-drained soils on nearly level to sloping uplands.

The CCR unit has been in place for 40 plus years and is used for the placement of CCR material; currently slurried bottom ash. The immediate watershed that drains to the CCR unit, and in which the CCR unit is considered to be located, is unnamed and 54.13 acres in size. The unnamed watershed discharges from the CCR impoundment outflow structure and is routed to the Green River.

The west dike is generally less than 5-feet in height and the south dike reaches a maximum height of 19.5 feet. The east dike reaches a maximum height of approximately 8 feet and is buttressed with a secondary parallel embankment that serves as a 40-foot wide roadway. The Burns and Roe, Inc., Engineering and Consultants June 30, 1978, site grading plans show the original construction layout and ground contours for the impoundment site. Bottom ash has been placed above the normal pool along the inboard side, essentially creating reclaimed land.

The impoundment discharge consists of two corrugated steel pipes, each 30 inches in diameter. The pipe intakes are through a common concrete headwall collection structure with a variable height steel debris deflector on each pipe intake.

2.0 GEOLOGY

The site lies in the Western Kentucky Coalfields, a gently rolling upland. In the vicinity of the site, maximum topographic relief is on the order of 80 feet. Surface drainage is to the south to Groves Creek, a primary tributary to the Green River, and to the east to the Green River.

Published geologic mapping (Murphy, 2007) shows the site to be immediately underlain by unconsolidated loess representing the Pleistocene and Holocene geologic epoch and unconsolidated alluvium representing the Pleistocene and Holocene epochs. The loess reportedly consists of sandy and clayey silt. The alluvium reportedly consists of silt and clay with lesser amounts of sand and gravel.

The unconsolidated materials are shown to be underlain by the base of the Shelburn Formation (formerly identified as the Lisman Formation (Fairer, 1973)) and the Carbondale Formation, both of which represent the Pennsylvanian Geologic Period. The West Franklin Member consists of one to three layers of limestone interbedded by calcareous clay shale, and comprises the top of the Shelburn Formation. The Providence Limestone Member, consisting of limestone and interbedded shale, comprises the base of the Shelburn Formation. The Providence Limestone Member is reportedly absent in much of the area due to erosional channeling. Due to its discontinuous character and the presence of interbedded shale, hydrologically significant karst features are not present in the Providence Limestone Member. The underlying Carbondale Formation consists of cyclic sequences of sandstones, shales, siltstones and coals. The Carbondale sediments were deposited in a fluvial-deltaic system. As a result of this depositional environment, the lithologic units of the Carbondale tend to be lenticular bodies rather than continuous sheet-like strata. Gradational and abrupt horizontal changes in lithology are often encountered.

The structure contours illustrated on the geologic map (Murphy, 2007) are based on the altitude of the No. 9 coal seam, and show the site to lie on the flank of a gentle anticline. Stratigraphic dip is shown to be on the order of 35 feet per mile to the southeast. No faults or other significant structural features are depicted on the geologic map.

3.0 HYDROGEOLOGY

The stratigraphic interval considered as the most prominent water transmitting zone within and adjacent to the Sebree Generating Station is material identified as the Upper Sandstone Member (Sebree sandstone) of the Carbondale Formation. The United States Geologic Survey (USGS) Geologic Map of the Robards Quadrangle describes the Sebree sandstone sequence as "Siltstone, sandstone, shale and coal: Siltstone, light- to medium-gray, micaceous, thin-bedded, and locally calcareous. Sandstone, light- to medium-gray, grayish- and yellowish-brown, fine- to medium-grained slightly micaceous, thin-bedded to massive; locally fills channels."

For purposes of compliance with the CCR Rule groundwater monitoring requirements; this sequence, and in particular the member sandstone intervals, is considered to be the uppermost aquifer underlying the Green CCR Surface Impoundment.

The sandstone units in the upper Carbondale Formation reportedly can provide well yields of 500 gallons per day (gpd) or greater with some reported yields on the order of 30 gallons per minute [gpm] (Maxwell and Devaul, 1962). The Providence Limestone Member of the Shelburn Formation is reported to yield little to no water to wells. The lower Carbondale Formation, above and below the No. 9 coal seam, consists primarily of shales that reportedly yield little to no water to wells. Previous site-specific investigations, by others, have noted the presence of perched zones of saturation in the overlying unconsolidated materials.

3.1 Groundwater Monitoring System

Three temporary piezometers (P-10, P-11 and P-12) were installed adjacent to, and respectively; northwest, southwest and northeast of the Green CCR impoundment to determine the general direction of groundwater movement. Measured static water levels, from the highest to lowest elevation were observed in P-10 (highest), P-11 and P-12 (lowest) resulting in a calculated hydraulic gradient or apparent direction of groundwater movement is generally from northwest to southeast. This groundwater gradient characterization and the ability to locate monitoring wells specific to the CCR unit justify the placement of the minimum of one upgradient and three downgradient monitoring wells. The upgradient monitoring well (M-11) was installed adjacent to, and northwest of the impoundment. The downgradient monitoring wells (M-12, M-13 and M-14) were installed adjacent to, and respectively; south-southeast, southeast and east-northeast of the impoundment. All monitoring wells are completed in the stratigraphic interval described above. Approximate locations of the groundwater monitoring wells are shown on the Groundwater Monitoring Well Location Aerial Photo (**Attachment B**). Boring logs and well construction diagrams are presented as **Attachment C**.

3.2 Groundwater Flow

Water level data were collected from the unit during the nine baseline CCR monitoring events from March 2016 through October 2017 as summarized on **Table 1** of **Attachment A**.

These data and the piezometric surface map presented below (**Figure 3**) represent general conditions at the Surface Impoundment and support the following analysis.

Overall groundwater flow beneath the footprint of the Green Surface Impoundment is to the east/southeast towards the Green River located east of the impoundment. The hydraulic gradients calculated from seasonal high, mid-point, and low events during the baseline period ranged from 0.0159 to 0.0283 towards the east/southeast as presented in **Table 2** of **Attachment A**.

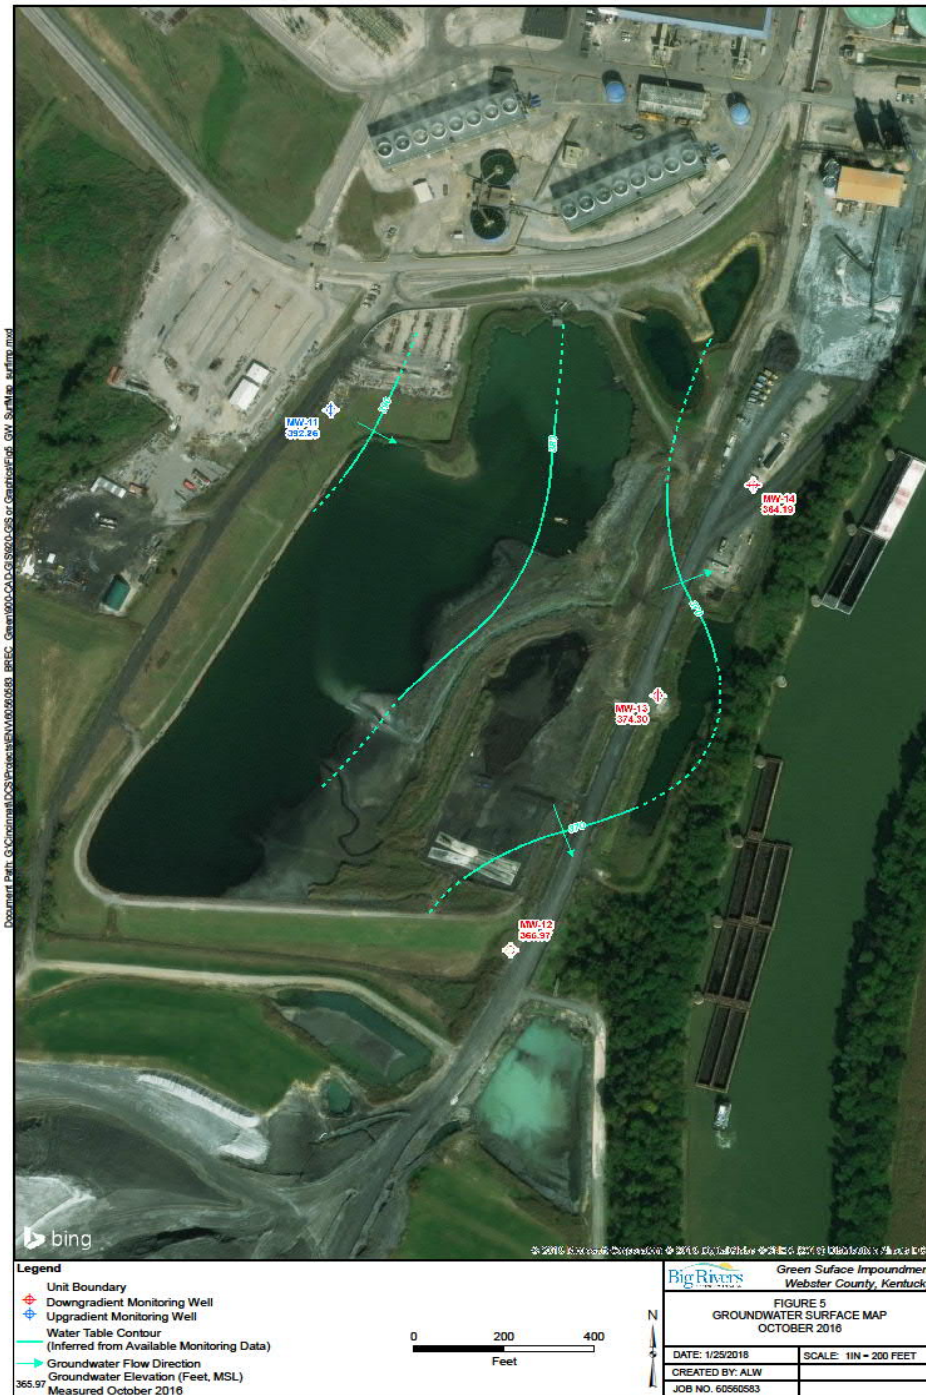


Figure 3: Green Surface Impoundment - Piezometric Surface Map

4.0 UPPERMOST AQUIFER

The “uppermost aquifer” is defined by 40 CFR §257.40 as the geologic formation nearest the natural ground surface that is an aquifer, as well as lower aquifers that are hydraulically interconnected with this aquifer within the facility’s property boundary. This definition includes a shallow, deep, perched, confined or unconfined aquifer, provided it yields usable water.

4.1 Aquifer Characteristics

Site-specific data pertaining to the aquifer characteristics beneath the Green Surface Impoundment were obtained prior to initiation of this CCR Program.

Available information pertaining to the sandstone units in the upper Carbondale Formation, identified as the uppermost aquifer beneath the Surface Impoundment, generally provide well yields of 500 gpd or greater with some reported yields on the order of 30 gpm (Maxwell and Devaul, 1962). The Providence Limestone Member of the Shelburn Formation is reported to yield little to no water to wells. The lower Carbondale Formation, above and below the No. 9 coal seam, consists primarily of shales that reportedly yield little to no water to wells. Previous site-specific investigations, by others, have noted the presence of perched zones of saturation in the overlying unconsolidated materials.

4.2 Placement Above the Uppermost Aquifer

Based on the available boring logs from the monitoring well system, the top of the upper Carbondale Formation (uppermost aquifer) is at an approximately elevation of 363 feet to the northwest (at MW-11), at 348 feet to the northeast (at MW-14), at 351 feet to the east (at MW-13), and not encountered to the southwest (at MW-12) of the Surface Impoundment. Illustrated well boring cross-sections are presented as **Attachment B**. Based on the interpreted top of the upper Carbondale Formation (uppermost aquifer), the base of the Surface Impoundment (360 feet) rests on or intercepts the uppermost aquifer within the northern most reaches of the Surface Impoundment and does not meet the 5-foot separation of the uppermost aquifer.

Groundwater data provided by BREC via baseline data collection from monitoring wells between March 2016 and October 2017 were used to interpret the elevations of the uppermost aquifer within the area of the Surface Impoundment. Seasonal measurements (April, June, August, October 2016, and January 2017) are presented within the Groundwater Elevation Summary located as **Attachment B**. Based on the cross sections presented in **Attachment B**, the potentiometric surface is approximately 5 feet (at MW-12) and 32 feet (at MW-11) above the lowest base of the Surface Impoundment (360 feet) and hydraulic connectivity cannot be disproven.

5.0 CONCLUSIONS

Available data regarding site groundwater, site geology, and physical limits of the unit for the Green Surface Impoundment do not evidence a 5-foot separation between the base of the impoundment and the uppermost limit of the uppermost aquifer and they do not support a lack of hydraulic connectivity between the unit and the aquifer as specified in 40 CFR §257.60(a). Therefore the unit does not meet the Placement above the Uppermost Aquifer requirement of 40 CFR §257.60(a).

6.0 REFERENCES

Burns and Roe, Inc., Engineering and Consultants, June 30, 1978, Site Grading Plans.

Fairer, G.M., Geologic Map of the Robards Quadrangle, Henderson and Webster Counties, Kentucky, U.S. Geological Survey, 1973.

Geotechnical and other information provided by Associated Engineers, Inc.

Engineering design drawings and other information provided by Big Rivers Electric Corporation.

Maxwell, B.W. and Devaul, R.W., Availability of Ground Water in Hopkins and Webster Counties, Kentucky, U.S. Geological Survey, 1962.

Murphy, 2007. Geological mapping.

United States Geological Survey U.S. Geological Survey (USGS) 7.5 minute Robards and Delaware topographic quadrangle maps

Attachments

Attachment A
Tables 1 and 2

TABLE 1
MONITORING WELL NETWORK GROUNDWATER ELEVATIONS - APRIL 2016 - OCTOBER 2017

BIG RIVERS ELECTRIC CORPORATION - SEBREE STATION
GREEN STATION SURFACE IMPOUNDMENT
WEBSTER COUNTY, KENTUCKY

Reference Elevation TOIC*(ft, NAD27)	GROUNDWATER MONITORING WELL NETWORK							
	MW-11		MW-12		MW-13		MW-14	
	Upgradient/Background 401.32		Downgradient 395.54		Downgradient 394.60		Downgradient 390.71	
Date Measured	Depth to Water (ft) (feet)	GW Elevation (feet)	Depth to Water (ft) (feet)	GW Elevation (feet)	Depth to Water (ft) (feet)	GW Elevation (feet)	Depth to Water (ft) (feet)	GW Elevation (feet)
4/1/2016	8.20	393.12	32.51	363.03	18.86	375.74	22.13	368.58
6/2/2016	8.32	393.00	29.62	365.92	18.83	375.77	23.01	367.7
8/16/2016	8.45	392.87	27.79	367.75	20.60	374	25.55	365.16
10/25/2016	9.06	392.26	29.57	365.97	20.30	374.3	26.52	364.19
1/26/2017	9.65	391.67						
1/27/2017			27.96	367.58	18.54	376.06	19.35	371.36
5/1/2017	10.12	391.20	26.93	368.61	19.23	375.37	24.01	366.7
8/11/2017	9.95	391.37	27.51	368.03	20.73	373.87	26.53	364.18
9/20/2017	9.97	391.35	32.20	363.34	20.68	373.92	26.03	364.68
10/9/2017	9.33	391.99	39.04	356.50	20.66	373.94	26.26	364.45

*Reference elevation of monitoring wells surveyed by Associated Engineers, Inc., Madisonville, Kentucky, January 2015
Survey coordinates were based on the Kentucky State Plane, Kentucky Southern Zone, NAD27 datum
TOIC = Top of internal casing
GW = Groundwater; GS = Ground Surface; NM = Not measured

TABLE 2

HYDRAULIC GRADIENT
GROUNDWATER MONITORING SYSTEM

BIG RIVERS ELECTRIC CORPORATION - SEBREE STATION
GREEN STATION SURFACE IMPOUNDMENT
WEBSTER COUNTY, KENTUCKY





	Well ID / GW Elevation (ft, NAD27)		Change in Head (feet)	Horizontal Distance* (feet)	Hydraulic Gradient
	MW-11	MW-12			
Apr 2016	393.12	363.03	30.09	1358	0.0222
Oct 2016	392.26	365.97	26.29	1358	0.0194
May 2017	391.20	368.61	22.59	1358	0.0166
	Well ID / GW Elevation (ft, NAD27)		Change in Head (feet)	Horizontal Distance* (feet)	Hydraulic Gradient
	MW-11	MW-13			
Apr 2016	393.12	375.74	17.38	996	0.0174
Oct 2016	392.26	374.30	17.96	996	0.0180
May 2017	391.20	375.37	15.83	996	0.0159
	Well ID / GW Elevation (ft, NAD27)		Change in Head (feet)	Horizontal Distance* (feet)	Hydraulic Gradient
	MW-11	MW-14			
Apr 2016	393.12	368.58	24.54	956	0.0257
Oct 2016	392.26	365.16	27.10	956	0.0283
May 2017	391.20	366.7	24.50	956	0.0256

*Reference elevation of monitoring wells surveyed by Associated Engineers, Inc.,
Madisonville, Kentucky, January 2015

Survey coordinates were based on the Kentucky State Plane, Kentucky Southern Zone, NAD27 datum

*Horizontal distance between monitoring wells, parallel to the direction of groundwater flow
(as determined by measurements utilizing Kentucky GIS)

Attachment B
Groundwater Elevation Summary

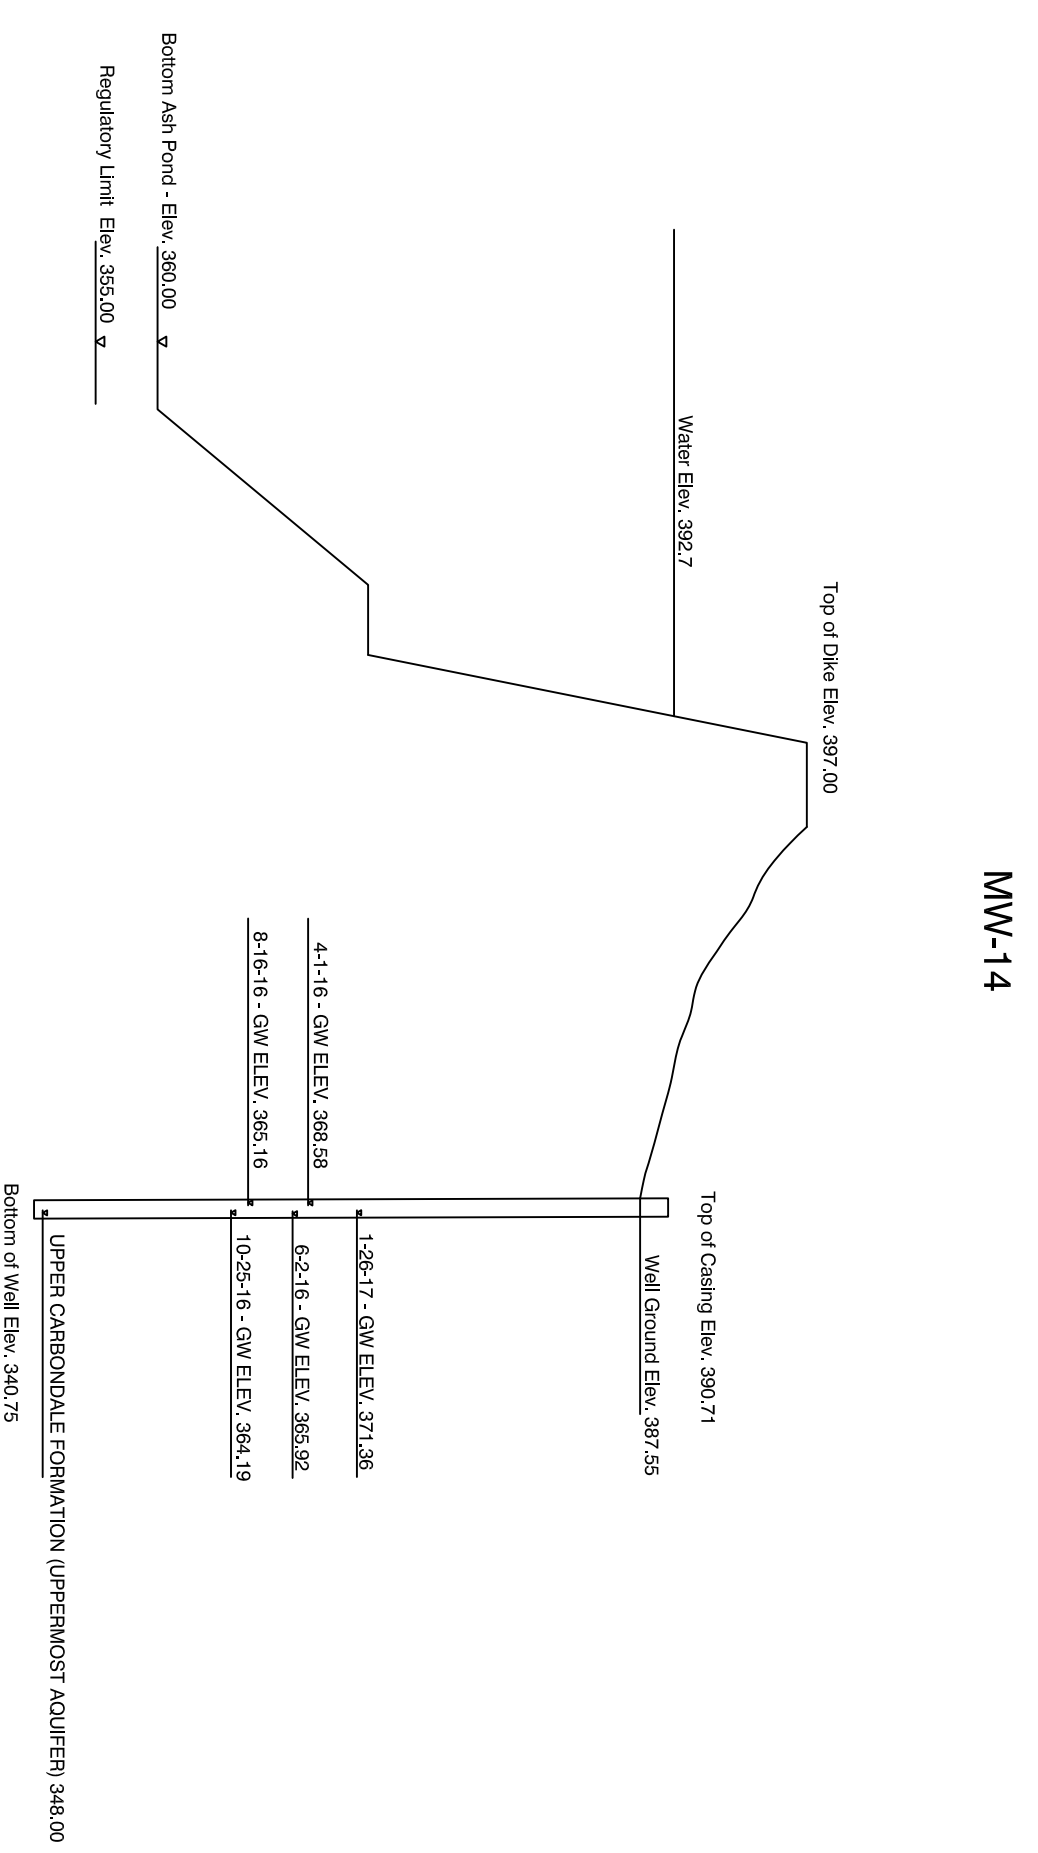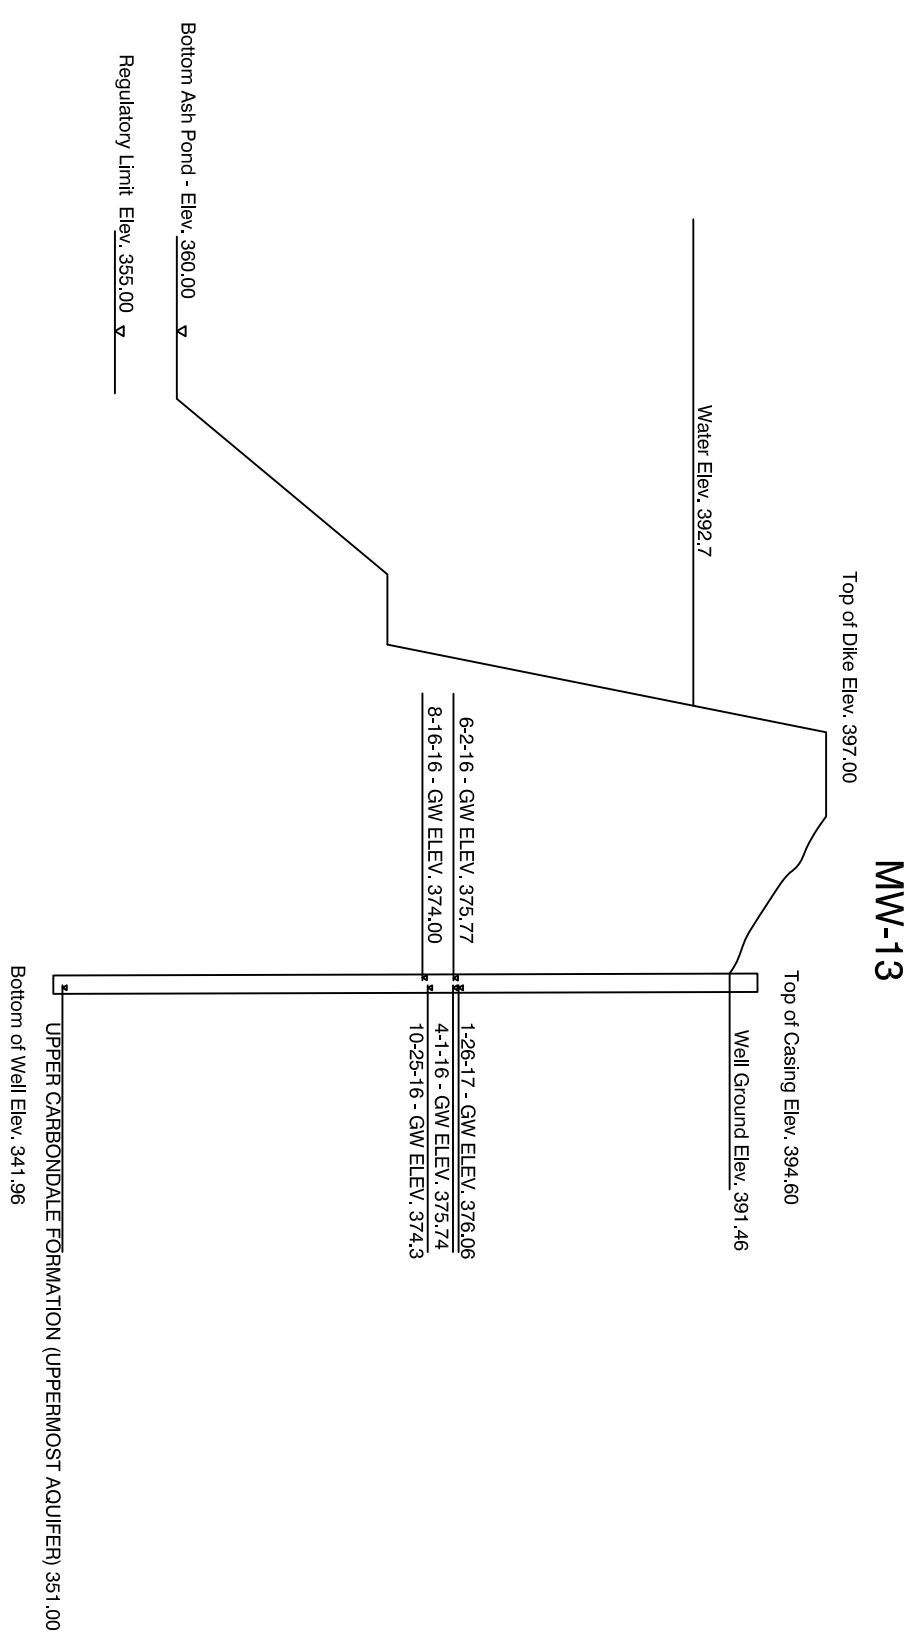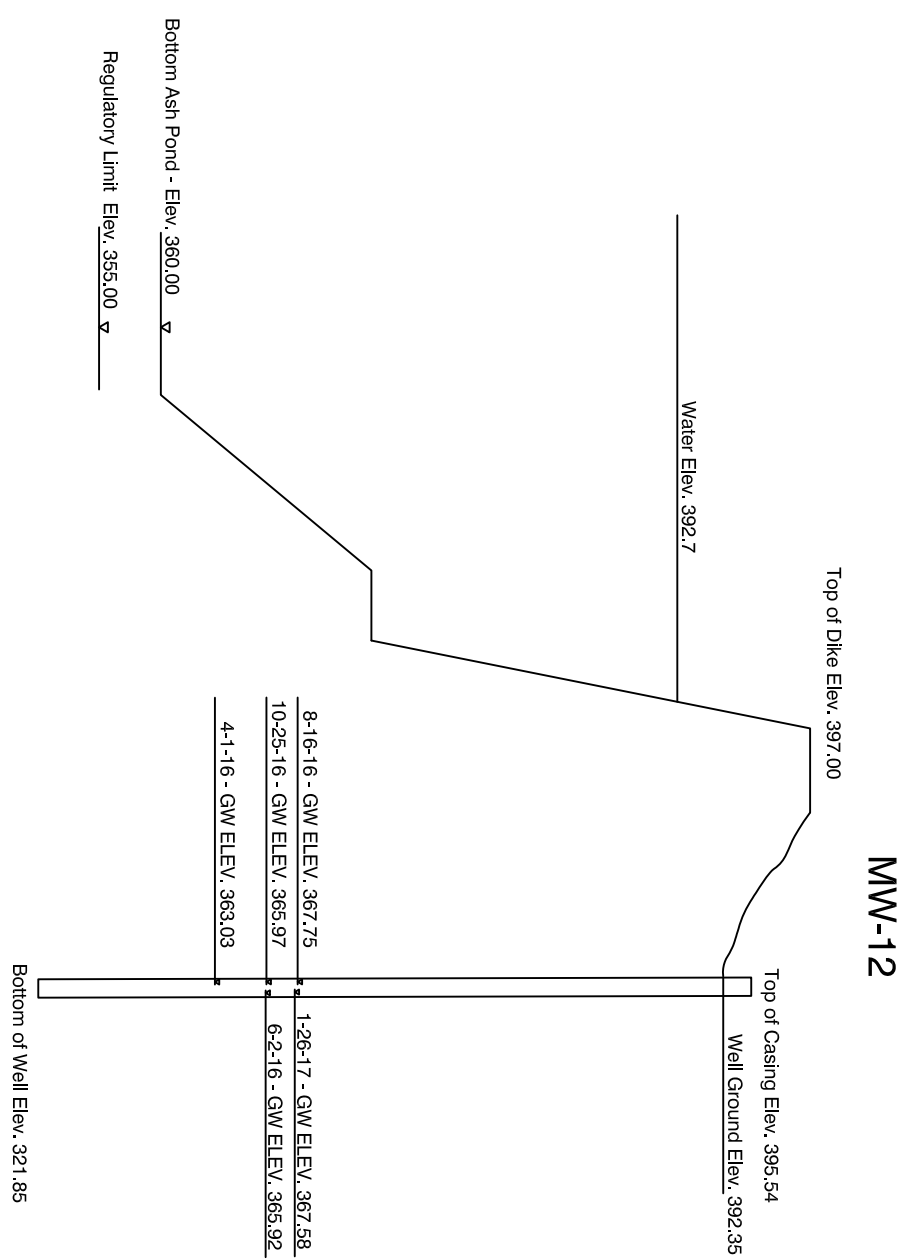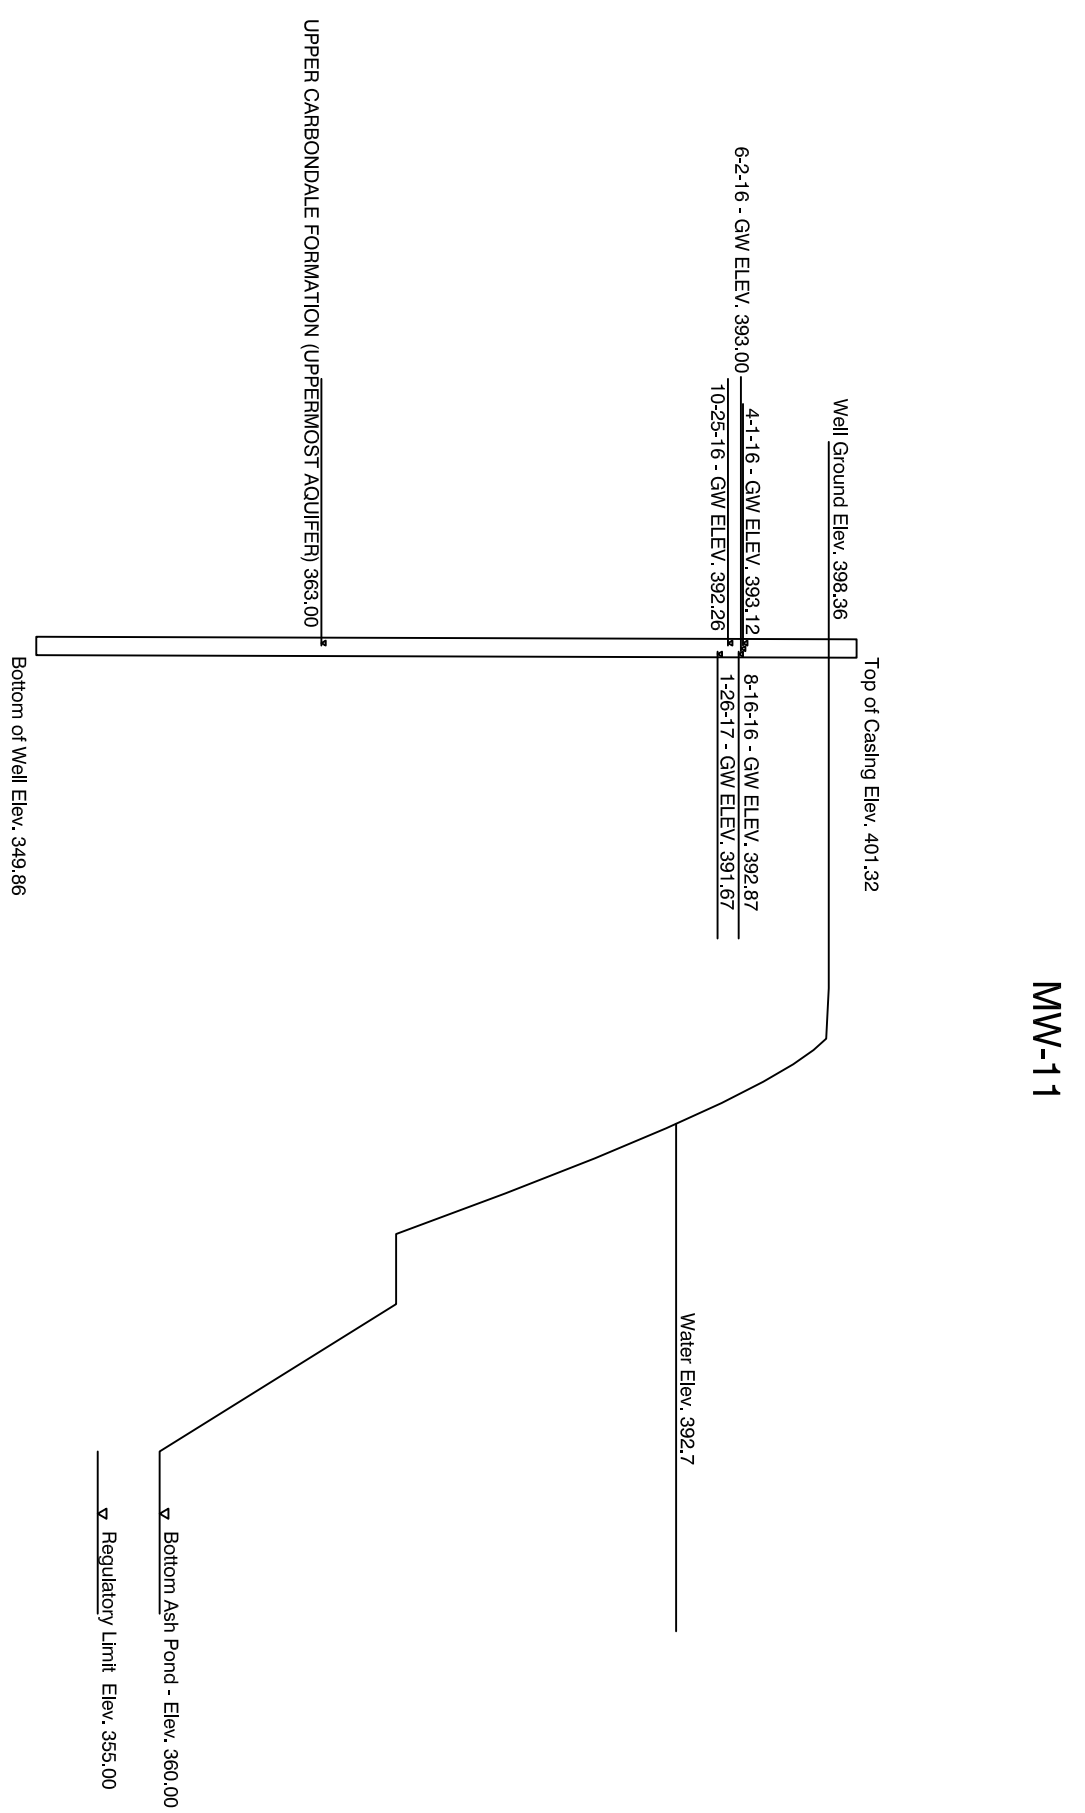

GREEN COAL COMBUSTION RESIDUALS SURFACE IMPONDMENT GROUNDWATER ELEVATION SUMMARY

Monitoring Well ID	Well Ground Elevation (feet, NAD27)	Top of Well Casing Elevation (feet, NAD27)	Total Well Depth (feet, TOIC)	Bottom of Well Elevation (feet, NAD27)	Depth to Top of Screened Interval (feet, GS)	Top of Screened Elevation (feet, NAD27)	Depth to Bottom of Screened Interval (feet, GS)	Bottom of Screened Elevation (feet, NAD27)	Bottom of Ash Pond Elevation	Date									
										4/1/2016	6/2/2016	8/16/2016	10/25/2016	1/26/2017					
MM-11	398.36	401.32	51.5	349.86	43.5	354.86	48.5	349.86	360.0	8.20	393.12	8.32	393.00	8.45	392.87	9.06	392.26	9.65	391.67
MM-12	397.35	395.54	73.7	321.85	60.5	331.85	70.5	321.85		32.51	363.03	29.62	365.92	27.79	367.75	29.57	365.97	27.96	367.58
MM-13	391.46	394.60	52.6	341.96	44.5	346.96	49.5	341.96		18.86	375.74	18.83	375.77	20.60	374.00	20.30	374.3	18.54	376.06
MM-14	387.55	390.71	50.0	340.75	41.8	345.75	46.8	340.75		22.13	368.58	23.01	367.7	25.55	365.16	26.52	364.19	19.35	371.36

Attachment C

Boring Logs and Well Construction Diagrams

UNIFORM KENTUCKY WELL CONSTRUCTION RECORD

Use this form only to report installation of monitoring or water wells.
Original copy must be submitted to Division of Water within 60 days of completion.
See instructions on reverse of form.
Record must be typed or neatly printed or it will be returned to the driller as unacceptable.
One copy to Division of Water, one copy to owner, one copy to driller's files.

8006-3938

4. Owner name Big Rivers Electric Corporation
5. Owner address 201 Third Street
6. City Henderson
7. State KY Zip 42420
8. State KY Zip 42420
9. Site name Sebree Station
10. Site address 9000 Highway 2096
11. City Robards
12. State KY Zip 42452
13. State KY Zip 42452

1. Kentucky Well ID (AKGWA) Number 8006 - 3938
2. Owner well ID# MW-11
3. Attachments Required
1. Site plan or sketch map
2. Well location On topographic map, OR Obtained by GPS unit
Conditionally Required
3. Well diagram (monitoring well)
4. Coliform analysis (if applicable)
5. Signed Variance (if applicable)
Optional
6. Other laboratory analysis report

14. Agency Interest (AI) Number 4196
15. Facility type CERCLA Solid Waste Drinking Water & RCRA UST Mining ID Number CCR Rule

16. Owner phone 270 - 844 - 6031 17. Site phone 270 - 521 - 7927

18. USGS topo map Robards
19. County Webster
20. Physiographic Region Blue Grass Ohio River Alluvium E. Coal Field W. Coal Field Miss. Plateau Jackson Purchase
21. Surface elevation (ft) 398.36
22. Elevation determined by GPS Map Prior report Survey Prior well log

29. Well use Agriculture Geothermal Jet wash Heat pump Push/probe Commercial HVAC Rotary - air Domestic Injection Rotary - mud Industrial Cable tool Rotary - reverse Core Sand point Driven Casing Sonic Excavation Unknown Combined - HS auger and air rotary Combined - other (specify):
NOTE: CODE REQUIRED for most well uses. See back of form for codes.

30. Drilling method Auger - HS Jet wash Auger - SS Push/probe Auger - bucket Rotary - air Auger - hand Rotary - mud Cable tool Rotary - reverse Core Sand point Driven Casing Sonic Excavation Unknown Combined - HS auger and air rotary Combined - other (specify):
Air-lift pump and water flush

31. Well status Active Inactive Unusable for intended use

32. Wellhead Flush Well cap Locking Sanitary seal

33. Well development method Surging Jetting Pumping Backwashing Bailing Compressed air Combination of methods (specify):
Air-lift pump and water flush

46. Well completion: Casing and screens

From depth (feet)	To depth (feet)	Borehole diameter (inches)		Casing diam (in)	Casing type	Screen slot size	From depth (feet)	To depth (feet)	Material
		ID	OD						
0.0	22.3	10.5	2.0	2.38	Sch 40 PVC		0.0	2.0	Concrete
22.3	43.5	6.5	2.0	2.38	Sch 40 PVC		2.0	39.5	Cement grout
43.5	48.5	6.5	2.0	2.38	Sch 40 Screen	0.010	39.5	41.5	Bentonite pellets
							41.5	49.9	Silica sand

47. Annulus fill and seal
48. Lithologic log (if more space is needed, continue on separate page)
49. Sketch map
See attachment

40. Depth to intake (ft) .
41. Apparent quality and odor
APPEARANCE Clear Cloudy Muddy Turbid
ODOR none slight mod high
of people served
42. Coliform test type fecal fecal and total
43. Coliform test results 0 or <1.0 TNTC Confluent
or # colonies per 100 mL
44. Date sampled Month Day Year
45. Date analyzed Month Day Year

34. Estimated well yield gpm gph gpd
35. Well service # of people served
36. Disinfectant amount 37. Type Bleach Hypo-chlorite
oz qt cups
lb gal
38. Pittless adapter installed Yes No
39. Pump installed: Submersible Jet Bailer or bucket Turbine Hand No pump
40. Depth to intake (ft) .
41. Apparent quality and odor
APPEARANCE Clear Cloudy Muddy Turbid
ODOR none slight mod high
of people served
42. Coliform test type fecal fecal and total
43. Coliform test results 0 or <1.0 TNTC Confluent
or # colonies per 100 mL
44. Date sampled Month Day Year
45. Date analyzed Month Day Year

50. Comments
4 1/4" ID HSA followed by 10 1/2" drag bit advanced to 22.3'. 8" ID PVC casing set to 22.3'. 6 1/2" tricone bit advanced to 49.9'. Silica sand set 48.5-49.9'. 2" casing and screen set. Sand set 41.5'-49.9'. Bentonite pellets set 39.5'-41.5'. After minimum 8 hour hydration time, cement grout set 22.3'-39.5' using tremie method. 8" casing pulled and grouting continued to 2'. Protective surface casing and pad installed after grout cured.

COLIFORM TEST
42. Coliform test type fecal fecal and total
43. Coliform test results 0 or <1.0 TNTC Confluent
or # colonies per 100 mL
44. Date sampled Month Day Year
45. Date analyzed Month Day Year

51. Affirmation: The work described above was done under my supervision, and this report is true and correct to the best of my knowledge.
Note: the driller is not responsible for natural groundwater quality or quantity encountered while drilling or completing this well.
Signature of certified driller [Signature]
Date signed 5/27/16
Drilling company Associated Engineers, Inc.
Certification number 0219-0364-00


Latitude 37.642616
Longitude -87.503252
Lat/Long Method INT GPS SUR REP
Date Received 5/27/16

ce 7/25/16

48. Lithologic Log MW-11

From depth (ft)	To depth (ft)	Description
0.0	0.3	Ash
0.3	2.0	Silty clay light brown
2.0	3.1	Silty clay brown
3.1	4.0	Silty clay light gray
4.0	6.7	Silty clay gray moist
6.7	15.0	Silty clay yellowish brown moist
15.0	21.3	Silty clay w/weathered shale light gray
21.3	22.3	Sandy shale light gray soft
	22.3	Auger refusal
22.3	33.0	Sandy shale gray
33.0	35.9	Claystone
35.9	40.4	Sandstone gray
40.4	41.5	Claystone
41.5	44.3	Sandstone gray water
44.3	45.1	Shale gray
45.1	49.9	Sandstone with carbonaceous strks gray water
	49.9	TD

**MONITORING WELL 8006-3938
(MW-11)**

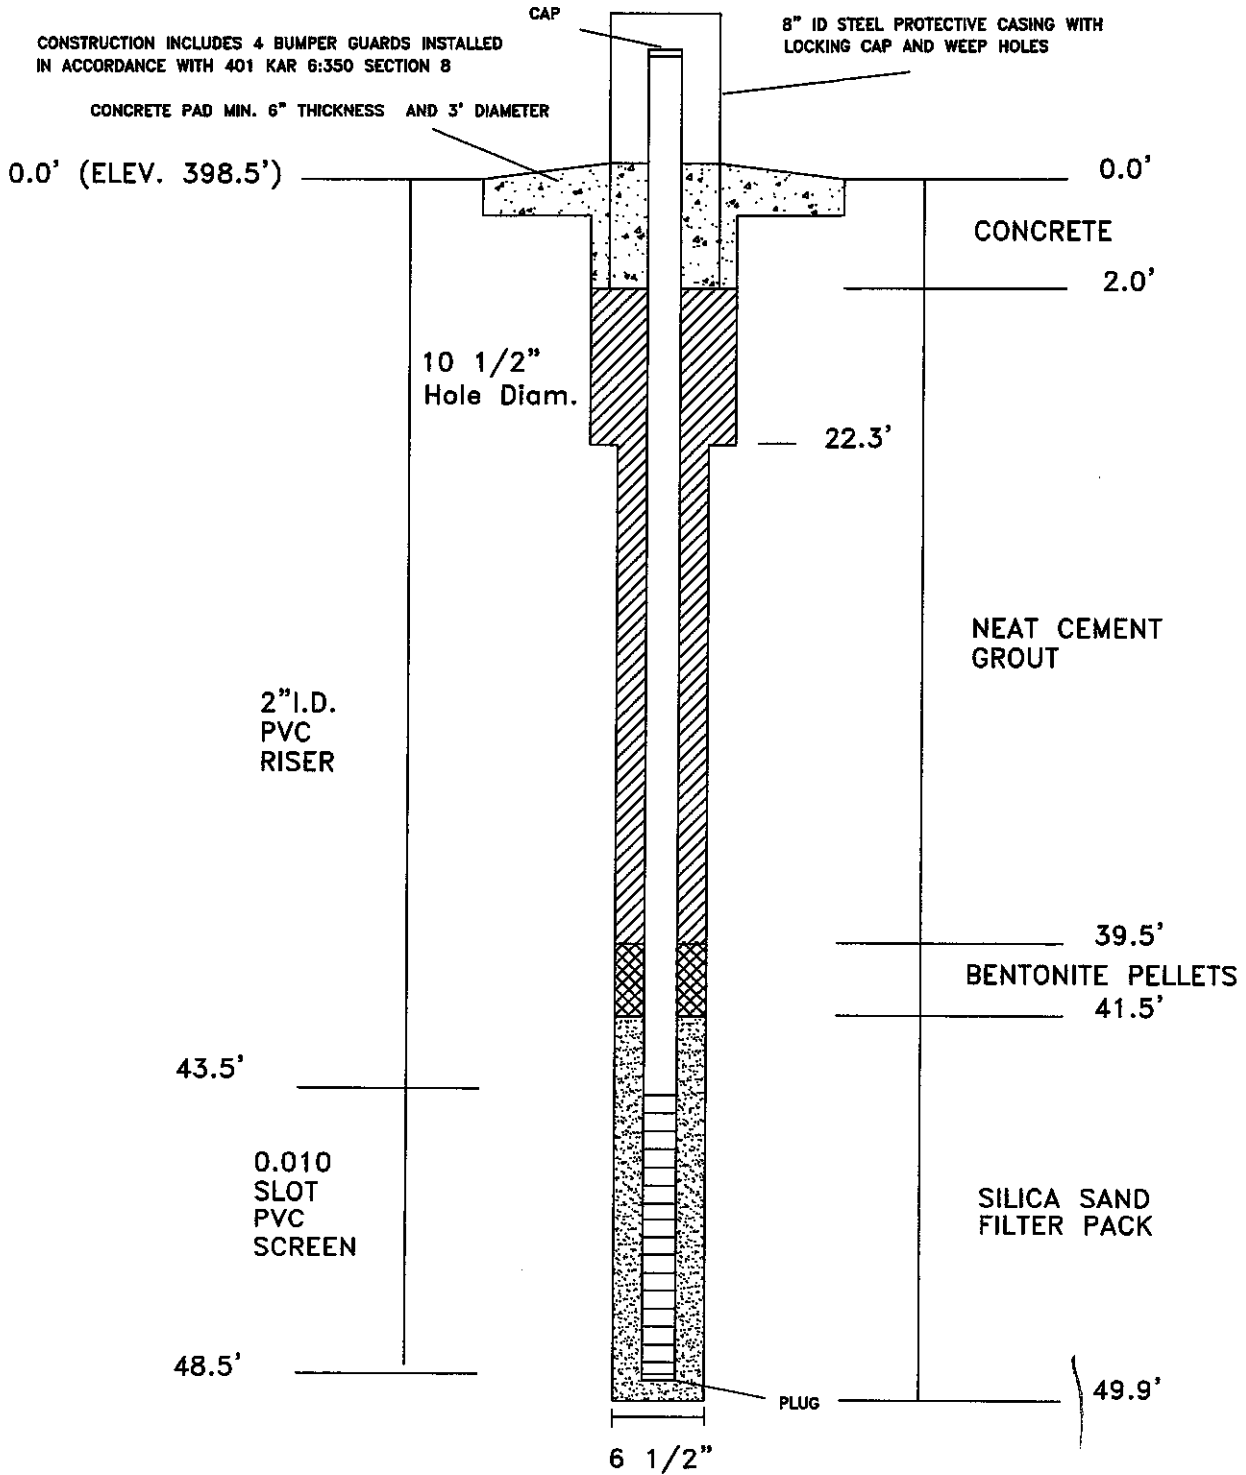

BIG RIVERS ELECTRIC CORPORATION

Well Construction Diagram

Job Number:	15-0140G	Revisions:
Date:	12/24/15	
Scale:	No Scale	
Drawn By:	D. Dunbar	

ASSOCIATED ENGINEERS, INC.

2740 North Main St. · Madisonville, KY 42431
 Phone: (270) 821-7732 · Fax: (270) 821-7789
 www.associatedengineers.com

UNIFORM KENTUCKY WELL CONSTRUCTION RECORD

Use this form only to report installation of monitoring or water wells.
Original copy must be submitted to Division of Water within 60 days of completion.
See instructions on reverse of form.

8006- 3939

Record must be typed or neatly printed or it will be returned to the driller as unacceptable.

One copy to Division of Water, one copy to owner, one copy to driller's files.

4. Owner name **Big Rivers Electric Corporation**

5. Owner address **201 Third Street**

6. City **Henderson**

7. State **KY**

8. Zip **42420**

If site name and address differ from owner name and address:

9. Site name **Sebree Station**

10. Site address **9000 Highway 2096**

11. City **Robards**

12. State **KY**

13. Zip **42452**

14. Agency Interest (AI) Number **4196**

15. Facility type
 CERCLA Solid Waste Drinking Water
 RCRA UST Mining
&
ID Number **CCR Rule**

1. Kentucky Well ID (AKGWA) Number

8006 - 3939

2. Owner well ID# **MW-12**

3. Attachments Required

- 1. Site plan or sketch map
- 2. Well location
On topographic map, OR
Obtained by GPS unit

Conditionally Required

- 3. Well diagram (monitoring well)
- 4. Coliform analysis (if applicable)
- 5. Signed Variance (if applicable)

Optional

- 6. Other laboratory analysis report

16. Owner phone **270 - 844 - 6031**

17. Site phone **270 - 521 - 7927**

23. Install start date

01 05 16
Month Day Year

24. Install end date

01 14 16
Month Day Year

18. USGS topo map **Robards**

19. County **Webster**

21. Surface elevation (ft) **392.35**

20. Physiographic Region
- Blue Grass
 - Ohio River Alluvium
 - E. Coal Field
 - W. Coal Field
 - Miss. Plateau
 - Jackson Purchase

22. Elevation determined by
- GPS
 - Map
 - Prior report
 - Survey
 - Prior well log

29. Well use
- Agriculture
 - Commercial
 - Domestic
 - Industrial
 - Monitoring / Remed **01**
 - Public
 - Geothermal
 - Heat pump
 - HVAC
 - Injection
 - Mining
 - Unused

30. Drilling method
- Auger - HS
 - Auger - SS
 - Auger - bucket
 - Auger - hand
 - Cable tool
 - Core
 - Driven Casing
 - Excavation
 - Combined - HS auger and air rotary
 - Combined - other (specify):
 - Jet wash
 - Push/probe
 - Rotary - air
 - Rotary - mud
 - Rotary - reverse
 - Sand point
 - Sonic
 - Unknown

31. Well status
- Active
 - Inactive
 - Unsuitable for intended use

32. Wellhead
- Flush
 - Locking
 - Well cap
 - Sanitary seal

33. Well development method
- Surging
 - Pumping
 - Bailing
 - Combination of methods (specify):
Air-lift pump and water flush
 - Jetting
 - Backwashing
 - Compressed air

Please report depths in feet below ground surface, not as relative elevations.

25. Total depth **72.0**

26. Depth to bedrock **55.0**

27. Static water level **29.32**

28. Casing height above surface (in) **38.28**

WATER WELLS ONLY

34. Estimated well yield gpm gph gpd

35. Well service #of people served

36. Disinfectant amount oz qt cups lb gal

37. Type Bleach Hypo-chlorite

38. Pitless adapter installed Yes No

39. Pump installed: Submersible Jet Turbine Hand Bailer or bucket No pump

40. Depth to intake (ft)

41. Apparent quality and odor
APPEARANCE: Clear Cloudy Muddy Turbid
ODOR: none slight mod. high
 Iron Sulfur Salt

COLIFORM TEST

42. Coliform test type fecal fecal and total

43. Coliform test results 0 or <1.0 TNTC Confluent

or # colonies per 100 mL

44. Date sampled
Month Day Year

45. Date analyzed

46. Well completion: Casing and screens

From depth (feet)	To depth (feet)	Borehole diameter (inches)	Casing diam (in)		Casing type	Screen slot size
			ID	OD		
0.0	56.5	10.5	2.0	2.38	Sch 40 PVC	
56.5	60.5	6.5	2.0	2.38	Sch 40 PVC	
60.5	70.5	6.5	2.0	2.38	Sch 40 Screen	0.010

47. Annulus fill and seal

From depth (feet)	To depth (feet)	Material
0.0	2.0	Concrete
2.0	56.5	Cement grout
56.5	58.5	Bentonite pellets
58.5	72.0	Silica sand

48. Lithologic log (if more space is needed, continue on separate page)

From depth (ft)	To depth (ft)	Description (include any show of water and indicate apparent quality)
		See attachment

49. Sketch map

See attachment

50. Comments
4 1/4" ID HSA followed by 10 1/2" drag bit advanced to 56.5'. 8" ID PVC casing set to 56.5'. 6 1/2" tricone bit advanced to 72.0'. Silica sand set 70.5'-72.0'. 2" casing and screen set. Sand set 58.5'-70.5'. Bentonite pellets set 58.5'-60.5'. After minimum 8 hour hydration time unable to pull 8" casing due to soil squeeze. Remaining annulus grouted with cement using tremie method. Protective surface casing and pad installed after grout cured.

Latitude **37.639148**

Longitude **-87.501824**

51. Affirmation: The work described above was done under my supervision, and this report is true and correct to the best of my knowledge. Note: the driller is not responsible for natural groundwater quality or quantity encountered while drilling or completing this well.

Signature of certified driller *[Signature]*

Date signed **5/25/16**

Certification number **0219-0364-00**

Drilling company **Associated Engineers, Inc.**

Lat/Long Method INT GPS SUR REP


Date Received **5/27/16**

ce 7/25/16

48. Lithologic Log MW-12

From depth (ft)	To depth (ft)	Description
0.0	4.0	Silty clay brown fill
4.0	12.6	Ash gray wet fill
12.6	13.6	Clay gray wet
13.6	21.2	Silty clay yellowish brown very moist
21.2	23.0	Silty clay yellowish brown very moist
23.0	31.5	Silty clay yellowish brown very moist
31.5	37.0	Silty clay brown, moist
37.0	40.5	Silty clay yellowish brown moist
40.5	52.0	Silty clay brown moist
52.0	55.0	Silty clay brown very moist
55.0	56.5	Shale gray soft
56.5	63.0	Shale gray
63.0	63.6	Shale and interbedded sandstone gray
63.6	72.0	Shale gray
	72.0	TD

MONITORING WELL 8006-3939 (MW-12)

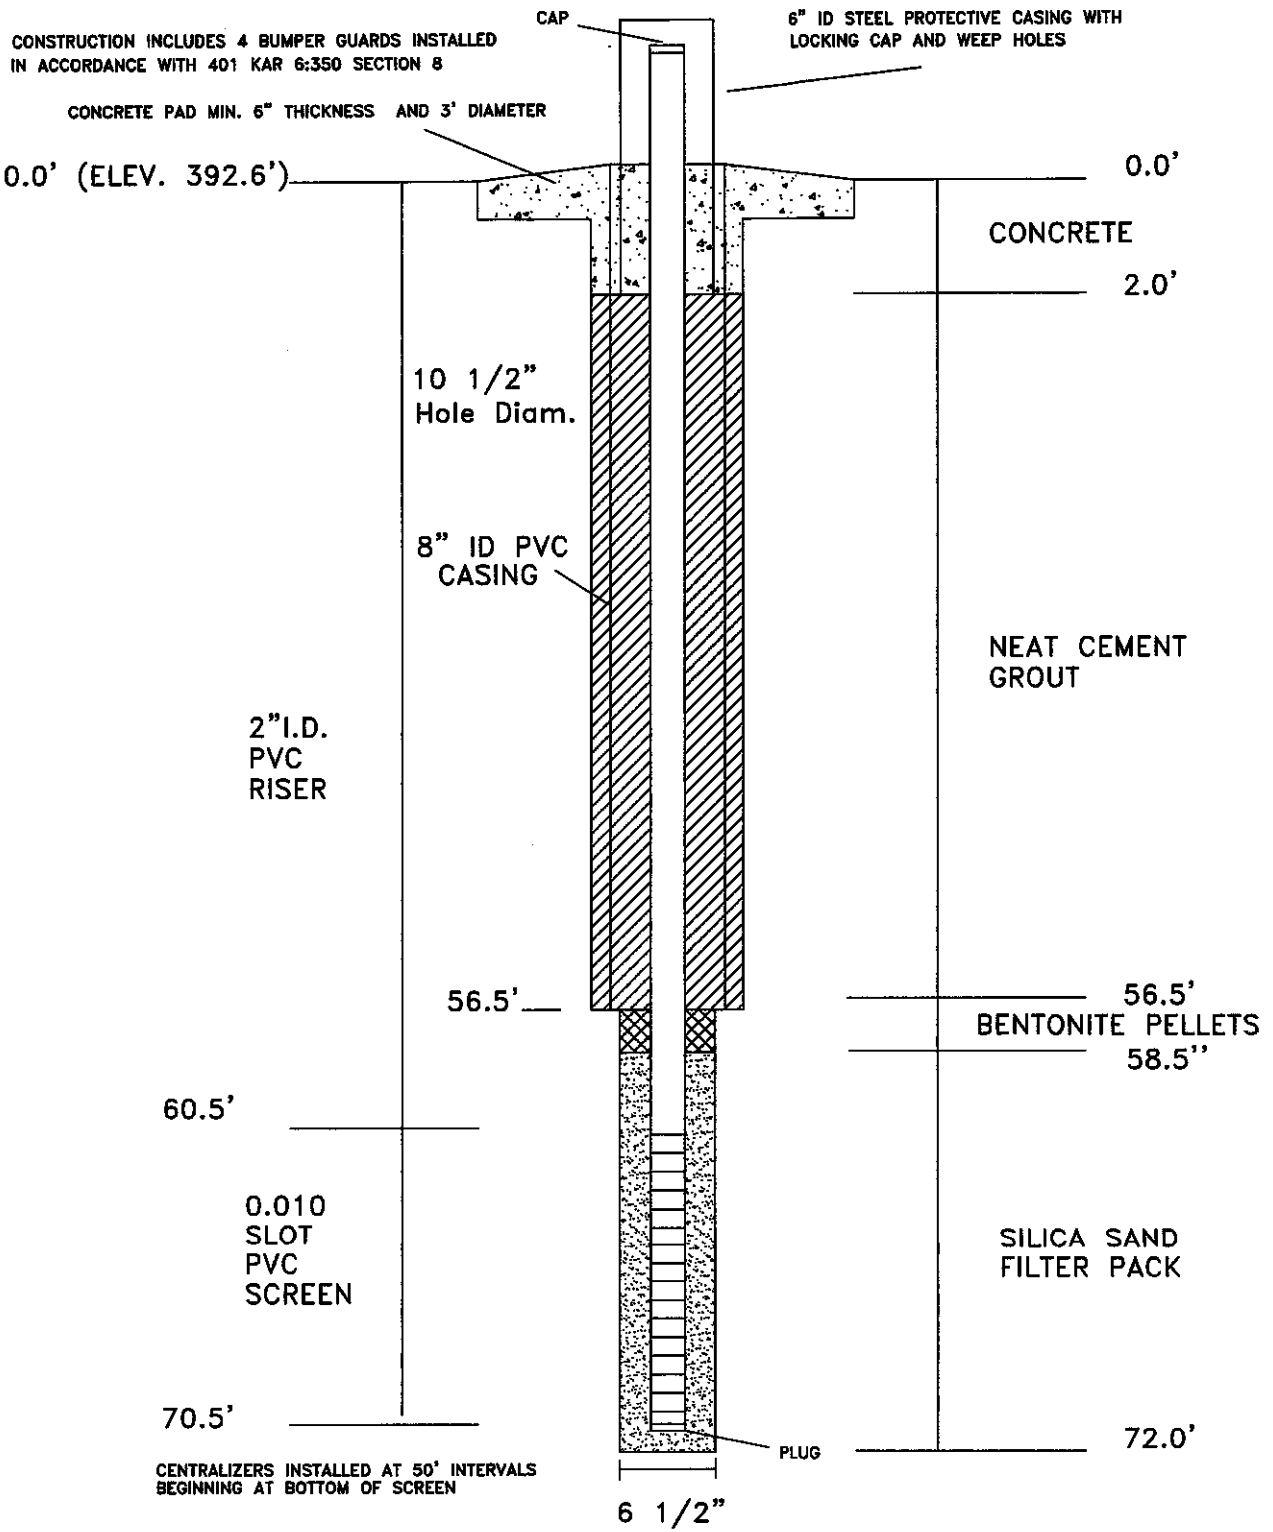

BIG RIVERS ELECTRIC CORPORATION

Well Construction Diagram

Job Number:	150140G	Revisions:
Date:	1/13/16	
Scale:	No Scale	
Drawn By:	D. Dunbar	



ASSOCIATED ENGINEERS, INC.

2740 North Main St. · Madisonville, KY 42431
 Phone: (270) 821-7732 · Fax: (270) 821-7789
www.associatedengineers.com

UNIFORM KENTUCKY WELL CONSTRUCTION RECORD

Use this form only to report installation of monitoring or water wells.
Original copy must be submitted to Division of Water within 60 days of completion.
See instructions on reverse of form.

8006- 3940

Record must be typed or neatly printed or it will be returned to the driller as unacceptable.

One copy to Division of Water, one copy to owner, one copy to driller's files.

4. Owner name: Big Rivers Electric Corporation
 5. Owner address: 201 Third Street
 6. City: Henderson
 7. State: KY
 8. Zip: 42420
 If site name and address differ from owner name and address:
 9. Site name: Sebree Station
 10. Site address: 9000 Highway 2096
 11. City: Robards
 12. State: KY
 13. Zip: 42452

1. Kentucky Well ID (AKGWA) Number: 8006 - 3940
 2. Owner well ID#: MW-13
 3. Attachments Required:
 1. Site plan or sketch map
 2. Well location: On topographic map, OR Obtained by GPS unit
 Conditionally Required:
 3. Well diagram (monitoring well)
 4. Coliform analysis (if applicable)
 5. Signed Variance (if applicable)
 Optional:
 6. Other laboratory analysis report

14. Agency Interest (AI) Number: 4196
 15. Facility type & ID Number: CERCLA Solid Waste Drinking Water
 RCRA UST Mining
 CCR Rule

16. Owner phone: 270 - 844 - 6031
 17. Site phone: 270 - 521 - 7927

23. Install start date: 12 / 28 / 15
 24. Install end date: 1 / 11 / 15

18. USGS topo map: Robards
 19. County: Webster
 20. Physiographic Region: Blue Grass Ohio River Alluvium
 E. Coal Field W. Coal Field
 Miss. Plateau Jackson Purchase
 21. Surface elevation (ft): 391.46
 22. Elevation determined by: GPS Map Prior report
 Survey Prior well log

Please report depths in feet below ground surface, not as relative elevations.
 25. Total depth: 51.5
 26. Depth to bedrock: 39.5
 27. Static water level: 15.52
 28. Casing height above surface (in): 37.68

29. Well use: Monitoring / Remed 01
 Agriculture Geothermal
 Commercial Heat pump
 Domestic HVAC
 Industrial Injection
 Mining
 Public Unused
 NOTE: CODE REQUIRED for most well uses. See back of form for codes.
 30. Drilling method: Combined - HS auger and air rotary
 Auger - HS Jet wash
 Auger - SS Push/probe
 Auger - bucket Rotary - air
 Auger - hand Rotary - mud
 Cable tool Rotary - reverse
 Core Sand point
 Driven Casing Sonic
 Excavation Unknown
 Combined - other (specify):
 31. Well status: Active Inactive
 Unsuitable for intended use
 32. Wellhead: Locking Sanitary seal
 Flush Well cap
 33. Well development method: Combination of methods (specify): Air-lift pump and water flush
 Surging Jetting
 Pumping Backwashing
 Bailing Compressed air

WATER WELLS ONLY
 34. Estimated well yield: gpm gph gpd
 35. Well service: # of people served

46. Well completion: Casing and screens

From depth (feet)	To depth (feet)	Borehole diameter (inches)	Casing diam (in)		Casing type	Screen slot size
			ID	OD		
0.0	40.5	10.5	2.0	2.38	Sch 40 PVC	
40.5	44.5	6.5	2.0	2.38	Sch 40 PVC	
44.5	49.5	6.5	2.0	2.38	Sch 40 Screen	0.010

47. Annulus fill and seal

From depth (feet)	To depth (feet)	Material
0.0	2.0	Concrete
2.0	40.5	Cement grout
40.5	42.5	Bentonite pellets
42.5	51.5	Silica sand

36. Disinfectant amount: oz qt cups lb gal
 37. Type: Bleach Hypo-chlorite
 38. Pitless adapter installed: Yes No
 39. Pump installed: Submersible Jet Bailer or bucket Turbine Hand No pump

48. Lithologic log (if more space is needed, continue on separate page)

From depth (ft)	To depth (ft)	Description (include any show of water and indicate apparent quality)
		See attachment

49. Sketch map: See attachment

40. Depth to intake (ft):
 41. Apparent quality and odor: Clear Cloudy Muddy Turbid
 ODOR: none slight mod. high
 Iron Sulfur Salt

COLIFORM TEST
 42. Coliform test type: fecal fecal and total
 43. Coliform test results: 0 or <1.0 TNTC Confluent
 or # colonies per 100 mL
 44. Date sampled: Month Day Year
 45. Date analyzed: Month Day Year

50. Comments: 4 1/4" ID HSA followed by 10 1/2" drag bit advanced to 40.5'. 8" ID PVC casing set to 40.5'. 6 1/2" tricone bit advanced to 51.5'. Silica sand set 49.5'-51.5'. 2" casing and screen set. Sand placed 42.5'-49.5'. Bentonite pellets set 40.5'-42.5'. 8" casing pulled after minimum 8 hour hydration time. Hole grouted 2'-40.5'. Protective surface casing and pad installed after grout cured.

Latitude: 37.640856
 Longitude: -87.500722

51. Affirmation: The work described above was done under my supervision, and this report is true and correct to the best of my knowledge. Note: the driller is not responsible for natural groundwater quality or quantity encountered while drilling or completing this well.

Signature of certified driller: [Signature]
 Date signed: 5/25/16
 Certification number: 0219-0364-00
 Drilling company: Associated Engineers, Inc.

Lat/Long Method: INT GPS SUR REP
 Date Received: 5/27/16

ce 7/25/16


48. Lithologic Log MW-13

From depth (ft)	To depth (ft)	Description
0.0	1.0	Ash black
1.0	2.7	Silty clay gray
2.7	10.6	Silty clay yellowish brown
10.6	12.8	Silty clay light gray
12.8	23.5	Silty clay yellowish brown wet
23.5	34.2	Silty clay brown very moist
34.2	39.5	Silty clay yellowish brown very moist
39.5	40.5	Sandstone yellowish brown soft weathered
	40.5	Auger refusal
40.5	50.4	Sandstone yellowish brown soft weathered
50.4	51.1	Shale gray
51.1	51.5	Sandy shale gray
	51.5	TD

MONITORING WELL 8006-3940 (MW-13)

CONSTRUCTION INCLUDES 4 BUMPER GUARDS INSTALLED
IN ACCORDANCE WITH 401 KAR 6:350 SECTION 8


CONCRETE PAD MIN. 6" THICKNESS AND 3' DIAMETER

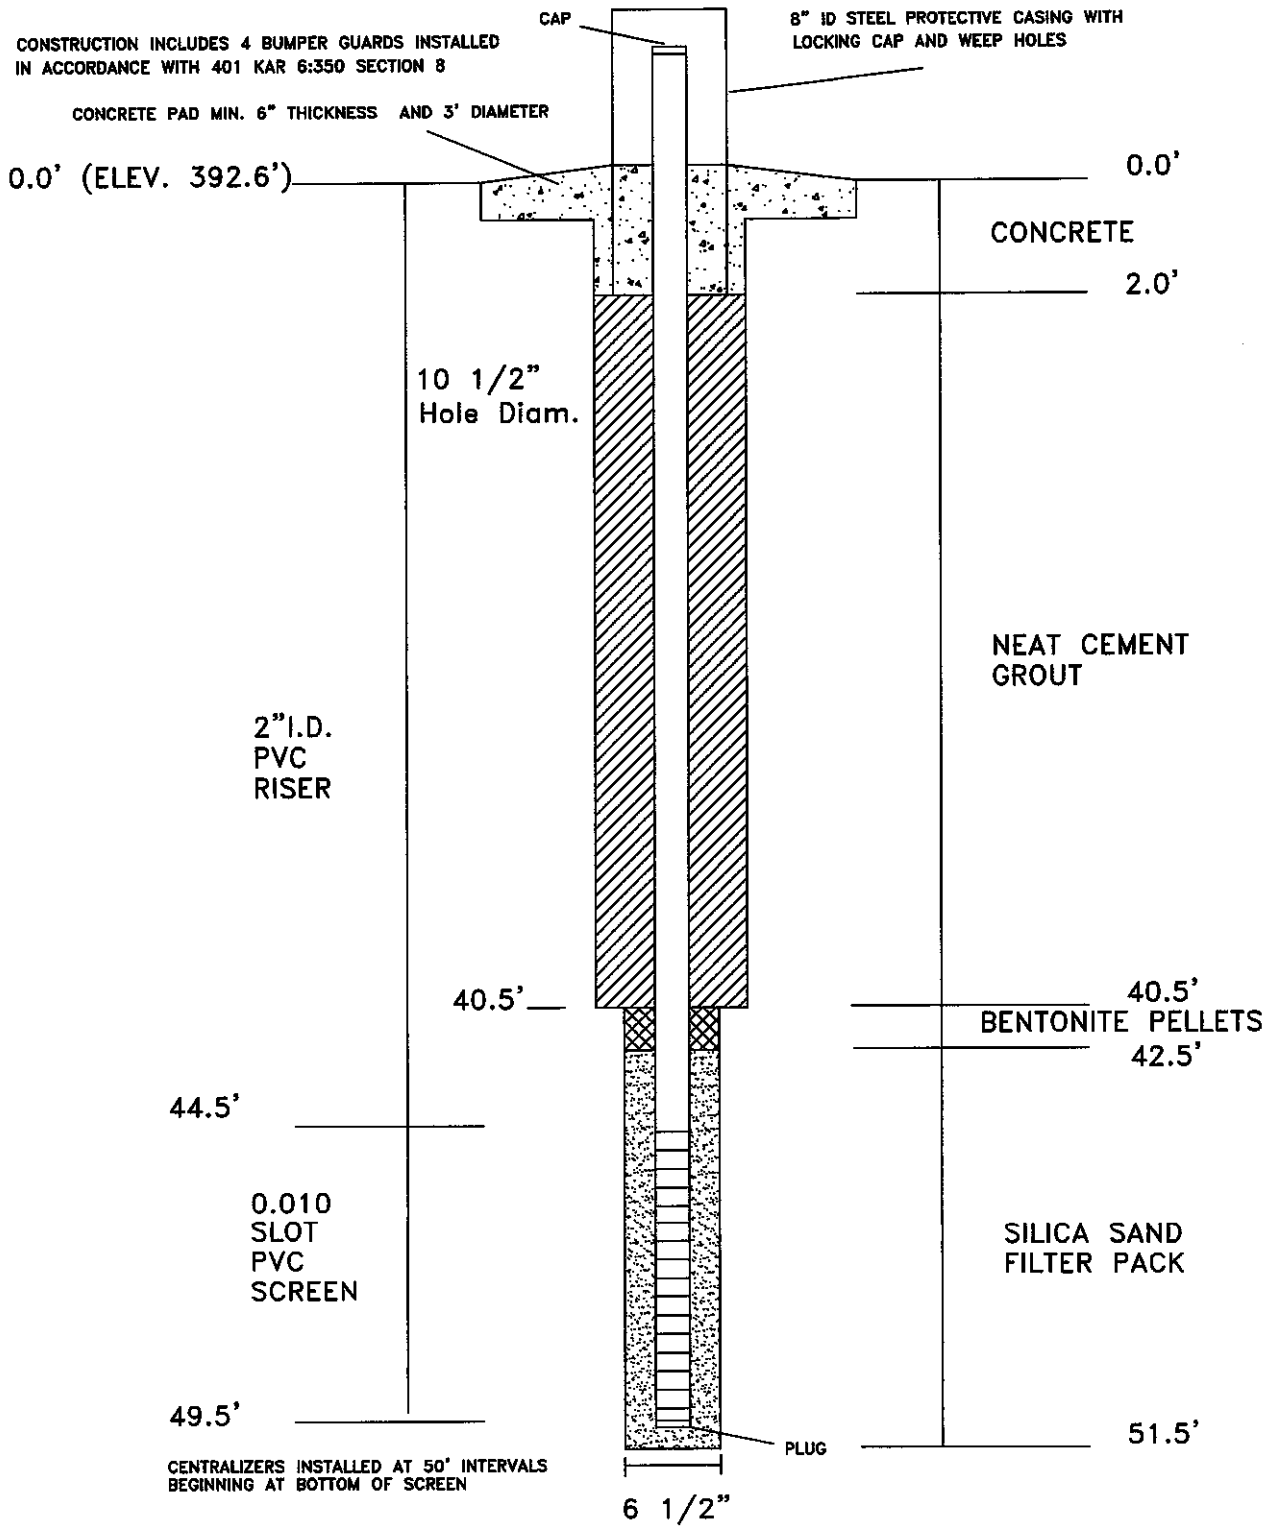

BIG RIVERS ELECTRIC CORPORATION

Well Construction Diagram

Job Number:	150140G	Revisions:
Date:	1/13/16	
Scale:	No Scale	
Drawn By:	D. Dunbar	

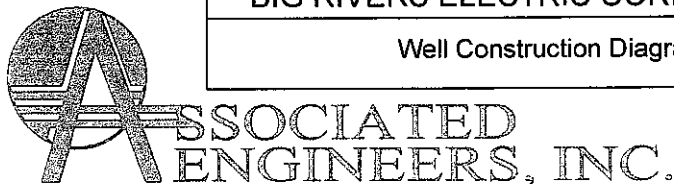

2740 North Main St. · Madisonville, KY 42431
Phone: (270) 821-7732 · Fax: (270) 821-7789
www.associatedengineers.com

UNIFORM KENTUCKY WELL CONSTRUCTION RECORD

Use this form only to report installation of monitoring or water wells.
Original copy must be submitted to Division of Water within 60 days of completion.
See instructions on reverse of form.

Record must be typed or neatly printed or it will be returned to the driller as unacceptable.

One copy to Division of Water, one copy to owner, one copy to driller's files.

8006- 3941

23

4. Owner name: Big Rivers Electric Corporation
 5. Owner address: 201 Third Street
 6. City: Henderson
 7. State: KY
 8. Zip: 42420
 9. Site name: Sebree Station
 10. Site address: 9000 Highway 2096
 11. City: Robards
 12. State: KY
 13. Zip: 42452

1. Kentucky Well ID (AKGWA) Number: 8006 - 3941
 2. Owner well ID#: MW-14
 3. Attachments Required:
 1. Site plan or sketch map
 2. Well location: On topographic map, OR
 Obtained by GPS unit
 Conditionally Required:
 3. Well diagram (monitoring well)
 4. Coliform analysis (if applicable)
 5. Signed Variance (if applicable)
 Optional:
 6. Other laboratory analysis report

14. Agency Interest (AI) Number: 4196
 15. Facility type: CERCLA Solid Waste Drinking Water
 RCRA UST Mining
 ID Number: CCR Rule

16. Owner phone: 270 - 844 - 6031
 17. Site phone: 270 - 521 - 7927

23. Install start date: 12 / 21 / 15
 24. Install end date: 1 / 7 / 15

18. USGS topo map: Robards
 19. County: Webster
 20. Physiographic Region: Blue Grass Ohio River Alluvium
 E. Coal Field W. Coal Field
 Miss. Plateau Jackson Purchase
 21. Surface elevation (ft): 387.55
 22. Elevation determined by: GPS Map Prior report
 Survey Prior well log

Please report depths in feet below ground surface, not as relative elevations.
 25. Total depth: 49.6
 26. Depth to bedrock: 21.9
 27. Static water level: 18.97
 28. Casing height above surface (in): 37.92

29. Well use: Agriculture Geothermal Commercial Heat pump
 Domestic HVAC Industrial Injection
 Monitoring / Remed Mining Public Unused
 NOTE: CODE REQUIRED for most well uses. See back of form for codes.
 30. Drilling method: Auger - HS Jet wash Auger - SS Push/probe
 Auger - bucket Rotary - air Auger - hand Rotary - mud
 Cable tool Rotary - reverse Core Sand point
 Driven Casing Sonic Excavation Unknown
 Combined - HS auger and air rotary Combined - other (specify):
 31. Well status: Active Inactive Unsuitable for intended use
 32. Wellhead: Flush Well cap Locking Sanitary seal
 33. Well development method: Surging Jetting Pumping Backwashing
 Bailing Compressed air Combination of methods (specify):
 Air-lift pump and water flush

WATER WELLS ONLY
 34. Estimated well yield: gpm gph gpd
 35. Well service: # of people served

46. Well completion: Casing and screens

From depth (feet)	To depth (feet)	Borehole diameter (inches)	Casing diam (in) ID	Casing diam (in) OD	Casing type	Screen slot size
0.0	24.7	10.5	2.0	2.38	Sch 40 PVC	
24.7	41.8	6.5	2.0	2.38	Sch 40 PVC	
41.8	46.8	6.5	2.0	2.38	Sch 40 Screen	0.010

47. Annulus fill and seal

From depth (feet)	To depth (feet)	Material
0.0	2.0	Concrete
2.0	37.8	Cement grout
37.8	39.8	Bentonite pellets
39.8	49.6	Silica sand

36. Disinfectant amount: oz qt cups lb gal
 37. Type: Bleach Hypo-chlorite
 38. Pitless adapter installed: Yes No
 39. Pump installed: Submersible Jet Turbine Hand Bailer or bucket No pump

48. Lithologic log (if more space is needed, continue on separate page)

From depth (ft)	To depth (ft)	Description (include any show of water and indicate apparent quality)
		See attachment

49. Sketch map: See attachment

40. Depth to intake (ft):
 41. Apparent quality and odor:
 APPEARANCE: Clear Cloudy Muddy Turbid
 ODOR: none slight mod. high
 Iron Sulfur Salt
 COLIFORM TEST
 42. Coliform test type: fecal fecal and total
 43. Coliform test results: 0 or <1.0 TNTC Confluent
 or # colonies per 100 mL
 44. Date sampled: Month Day Year
 45. Date analyzed: Month Day Year

50. Comments: 4 1/4" ID HSA followed by 10 1/2" drag bit advanced to 24.7'. 8" ID PVC casing set to 24.7'. 6 1/2" tricone bit advanced to 49.6'. Silica sand set 46.8-49.6'. 2" casing and screen set. Sand set 39.8-46.8'. Bentonite pellets set 37.8-39.8'. After minimum 8 hour hydration time, cement grout set 24.7'-37.8' using tremie method. 8" casing pulled and grouting continued to 2'. Protective surface casing and pad installed after grout cured.

Latitude: 37.642198
 Longitude: -87.500009

51. Affirmation: The work described above was done under my supervision, and this report is true and correct to the best of my knowledge. Note: the driller is not responsible for natural groundwater quality or quantity encountered while drilling or completing this well.

Lat/Long Method: INT GPS SUR REP

Signature of certified driller: [Signature]

Date signed: 5/25/16

Date Received: 5/27/16

Certification number: 0219-0364-00


Drilling company: Associated Engineers, Inc.

ce 7/25/16

48. Lithologic Log MW-14

From depth (ft)	To depth (ft)	Description
0.0	2.4	Ash black
2.4	3.8	Silty clay yellowish brown
3.8	11.2	Silty clay brown
11.2	16.9	Silty clay yellowish brown w/sandstone fragments
16.9	21.9	Sandstone yellowish brown soft weathered
21.9	24.7	Shale gray soft
	24.7	Auger refusal
24.7	26.5	Shale gray soft
26.5	39.8	Sandy shale gray
39.8	48.3	Sandstone gray, water
48.3	49.1	Shale and interbedded sandstone gray
49.1	49.3	Sandstone gray
49.3	49.6	Shale gray
	49.6	TD

**MONITORING WELL 8006-3941
(MW-14)**

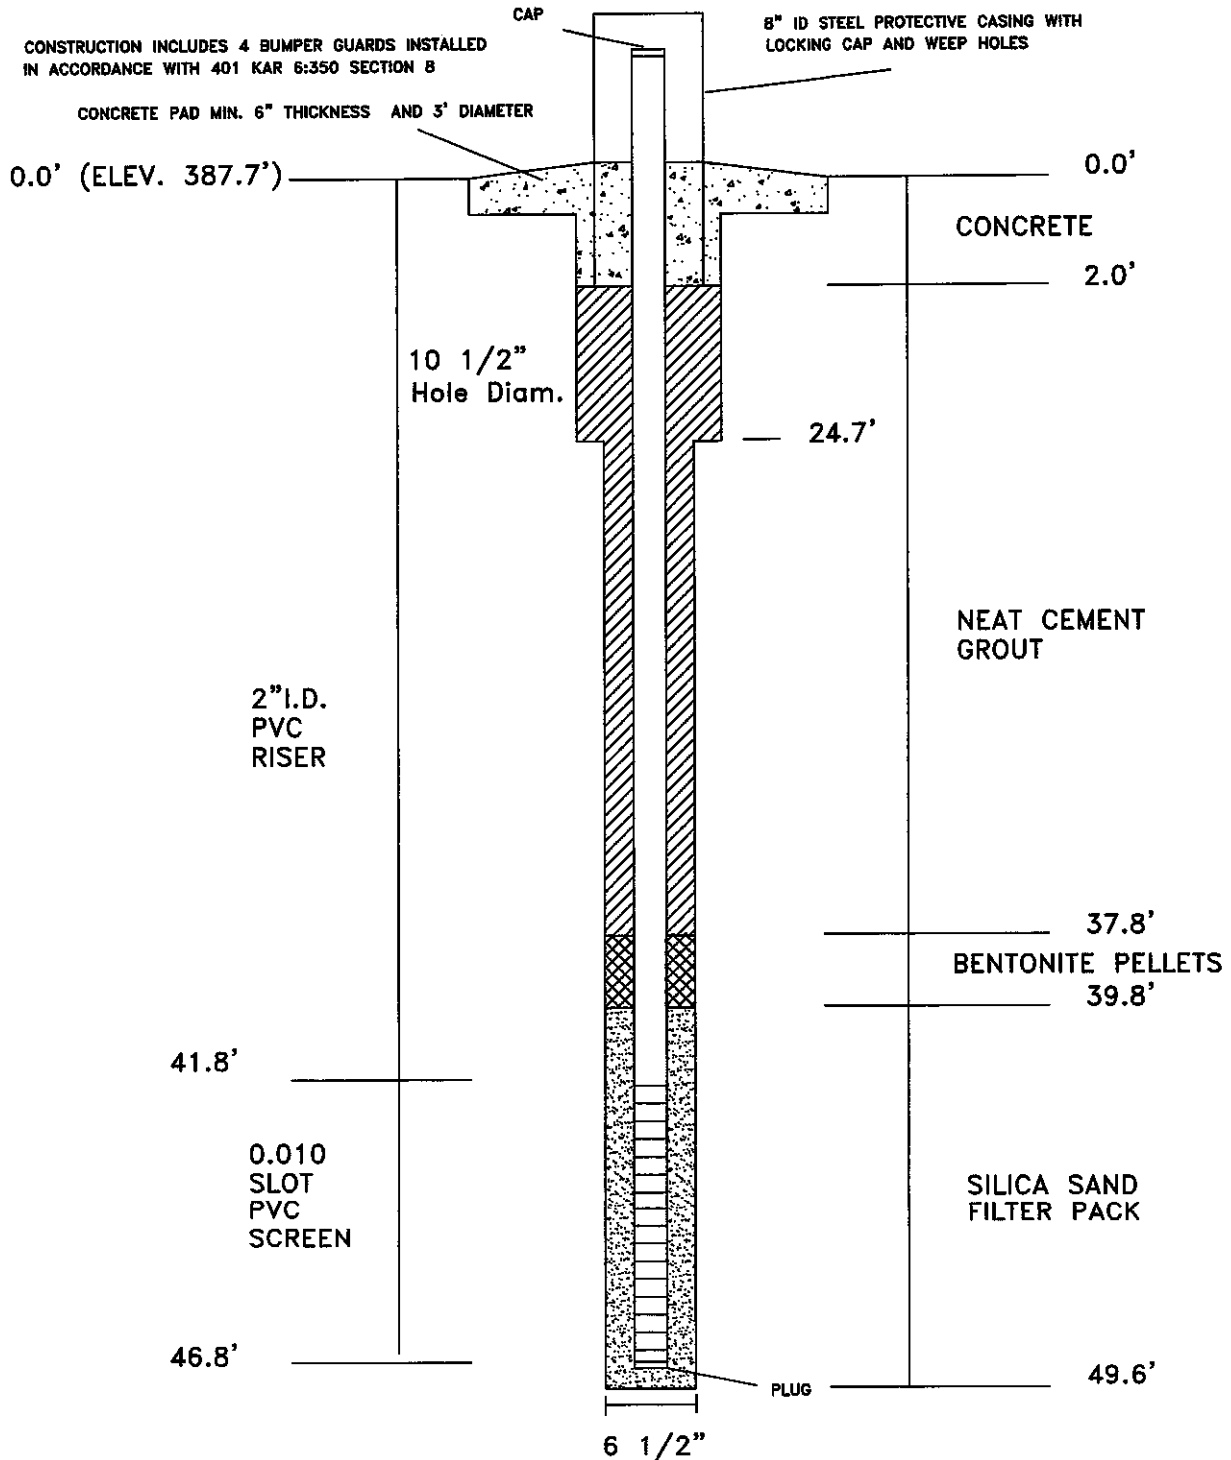

BIG RIVERS ELECTRIC CORPORATION

Well Construction Diagram

Job Number:	15-0140G	Revisions:
Date:	1/13/16	
Scale:	No Scale	
Drawn By:	D. Dunbar	

ASSOCIATED ENGINEERS, INC.

2740 North Main St. · Madisonville, KY 42431
 Phone: (270) 821-7732 · Fax: (270) 821-7789
 www.associatedengineers.com



AECOM
500 W Jefferson St.
Suite 1600
Louisville, KY 40202
www.aecom.com

502-569-2301 tel
502-569-2304 fax

October 17, 2018

Big Rivers Electric Corporation
Sebree Generating Station
9000 Highway 2096
Robards, Kentucky 42452

**Engineer's Certification of Placement Above the Uppermost Aquifer Demonstration
Existing Reid/HMPL CCR Surface Impoundment
EPA Final CCR Rule
Sebree Station
Robards, Kentucky**

1.0 PURPOSE

The purpose of this document is to certify that the Placement above Sebree "Reid/HMPL" Existing CCR Surface Impoundment is in compliance with the Placement above the Uppermost Aquifer requirement of the Final CCR Rule at 40 CFR §257.60. Presented below is the project background, summary of findings, limitations and certification.

2.0 BACKGROUND

In accordance with 40 CFR §257.60, the owner/operator of an existing CCR Surface Impoundment must demonstrate that the base of the unit is located no less than 1.52 meters (five feet) above the upper limit of the uppermost aquifer, or must demonstrate that there will not be an intermittent, recurring, or sustained hydraulic connection between any portion of the base of the CCR unit and the uppermost aquifer due to normal fluctuations in groundwater elevations (including the seasonal high water table). In accordance with 40 CFR §257.60(c)(1), the demonstration must be made by October 17, 2018. If such demonstration cannot be made, the unit is subject to the closure or retrofit requirements of 40 CFR §257.101

3.0 SUMMARY OF FINDINGS

Available data regarding site groundwater, site geology, and physical limits of the unit for the Reid/HMPL Surface Impoundment do not evidence a 5-foot separation between the base of the impoundment and the upper most limit of the uppermost aquifer and they do not support a lack of hydraulic connectivity between the unit and the aquifer as specified in 40 CFR §257.60(a). Therefore the unit does not meet the Placement above the Uppermost Aquifer requirement of 40 CFR §257.60(a).



4.0 CERTIFICATION

I, Michael Brian Cole, being a Registered Professional Engineer in good standing in the State of Kentucky, do hereby certify, to the best of my knowledge, information, and belief that the information contained in this certification has been prepared in accordance with the accepted practice of engineering. I certify, for the above-referenced CCR Unit, that the available data do not support a demonstration of Placement above the Uppermost Aquifer that meets the requirements of 40 CFR § 257.60(a).

M. Brian Cole
Printed Name

October 17, 2018
Date



ADDRESS: AECOM
500 W Jefferson St Suite 1600
Louisville, KY 40202

TELEPHONE: (502)-569-2301

ATTACHMENTS: Placement above the Uppermost Aquifer Demonstration for Coal Combustion Residuals



Your Touchstone Energy® Cooperative 

Existing “Reid/HMPL” CCR Surface Impoundment

**Disposal of Coal Combustion Residuals (CCR) from Electric
Utilities Final Rule**

**Placement above the Uppermost Aquifer Demonstration for
Coal Combustion Residuals (CCR)**

October 17, 2018

Prepared by

AECOM

Project Number: 60571713

TABLE OF CONTENTS

1.0	INTRODUCTION	1
1.1	Objective.....	1
1.2	Rule Requirements	1
1.3	Methodology/Background	1
1.4	Site Background.....	1
1.5	Site History	3
2.0	GEOLOGY	3
3.0	HYDROGEOLOGY	4
3.1	Groundwater Monitoring System.....	4
3.2	Groundwater Flow.....	5
4.0	UPPERMOST AQUIFER	7
4.1	Aquifer Characteristics.....	7
4.2	Placement Above the Uppermost Aquifer.....	7
5.0	CONCLUSIONS.....	8
6.0	REFERENCES	8

FIGURES

Figure 1. Site Location

Figure 2. Surface Impoundment Site Location

Figure 3. Surface Impoundment – Groundwater Contour Map – September 2017

ATTACHMENTS

Attachment A. Tables 1 and 2

Attachment B. Groundwater Elevation Summary

Attachment C. Boring Logs and Well Construction Diagrams

1.0 INTRODUCTION

1.1 Objective

The purpose of this demonstration is to document compliance with 40 Code of Federal Regulations (CFR §257.60 of the Environmental Protection Agency Final Coal Combustion Residual Rule (EPA Final CCR Rule) regarding the Placement above the Uppermost Aquifer Demonstration requirement for the existing “Reid/HMPL” Surface Impoundment at the Big Rivers Electric Corporation (BREC) Sebree Station in Sebree, Kentucky.

1.2 Rule Requirements

As required by 40 CFR §257.60(a) of the EPA Final CCR Rule, existing CCR Surface Impoundments must be constructed with a base that is located no less than 1.52 meters (5 feet) above the upper limit of the uppermost aquifer, or must demonstrate that there will not be an intermittent, recurring, or sustained hydraulic connection between any portion of the base of the CCR unit and the uppermost aquifer due to normal fluctuations in groundwater elevation. The “uppermost aquifer” is defined by 40 CFR §257.40 as the geologic formation nearest the natural ground surface that is an aquifer, as well as lower aquifers that are hydraulically interconnected with this aquifer within the facility’s property boundary. This definition includes a shallow, deep, perched, confined or unconfined aquifer, provided it yields usable water.

The demonstration is due by October 17, 2018 in accordance with 40 CFR §257.60(c)(1). Those Surface Impoundments that cannot demonstrate compliance with the requirement of 40 CFR §257.60(a) are required by 40 CFR §257.60(c)(4) to cease placement of CCR in the unit within 6 months (April 2019).

1.3 Methodology/Background

The demonstration method involves the use of existing documentation of pertinent geologic and hydrogeologic information to develop a conceptual site model (CSM) for the uppermost aquifer inclusive of the definition of its uppermost limit, normal fluctuations in groundwater elevation, and the potential for the aquifer’s hydraulic interconnection with overlying strata and the planned landfill limits. Existing documentation includes state and/or federal geologic maps and water resources publications, the logs of borings drilled on site for geotechnical purposes, the logs of monitoring wells installed on site and in surrounding areas, and design drawings for the unit.

1.4 Site Background

Big Rivers Electric Corporation (BREC) owns and operates the “Sebree” Station in Sebree, Kentucky. The Sebree Station is located in Webster County, approximately 3.2 miles northeast of the town of Sebree, Kentucky situated immediately east of the Pennyriple Parkway approximately 1.5 miles north of the intersection of the Pennyriple Parkway and Kentucky Route 56 (see Figure 1). Sebree Station is composed of 2 Green generating units, one Reid generating unit, and 2 HMP&L generating units. The Green Surface Impoundment is located directly south of the Sebree Station, situated north of the Green CCR Landfill. The current Green Surface Impoundment footprint is approximately 16 acres (Figure 2).

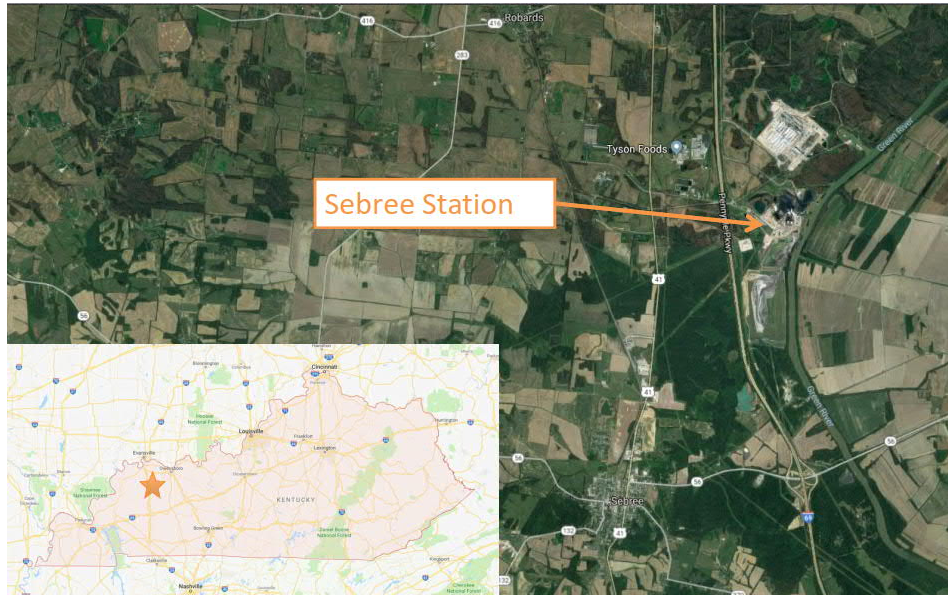


Figure 1: BREC Sebree Site Location



Figure 2: BREC Reid/HMPL Surface Impoundment Site Location

1.5 Site History

The Reid/HMPL Surface Impoundment is a combined incised/dike earthen embankment structure. It is diked on the west, south and east sides, while the north side is incised. The west dike has the greatest height reaching approximately 42 feet. The original terrain on which the Surface Impoundment was constructed generally sloped toward the west. Although the Green River is located less than 0.5 miles from the site, the structure does not extend significantly into the floodplain. Underlying preconstruction soils consisted of Loring-Grenada, Loring-Zanesville-Wellston (Henderson County) and Loring-Wellston-Zanesville (Webster County) soil associations are generally characterized as well drained to moderately well drained soils on nearly level to sloping uplands.

The CCR unit has been in place for 40 plus years and is used for the placement of CCR material; currently slurried bottom ash. The immediate watershed that drains to the CCR unit, and in which the CCR unit is considered to be located, is unnamed and 25.45 acres in size. The unnamed watershed discharges from the CCR impoundment outflow structure and is routed to the Green River.

The embankment reaches its greatest relief of approximately 42 feet on the west side. The Burns & McDonnell Engineering Co., October 8, 1971 design drawings show the inboard slope and central core portion of the dike to be constructed of compacted soil fill and the outboard slope to be consisted of sand fill. A sand blanket drain was designed for the outboard third of the base of the dike for the majority of the length and the plans show a crushed limestone drainage layer with a minimum thickness of 18 inches topped with a minimum 6-inches thick sand layer that extends across the entire width of the dike cross section in the southwest corner. The plans also show a cut-off trench in the original ground below dike crest and extending for the entire length of the dike.

The impoundment discharge consists of a rectangular concrete drop structure with a variable height steel debris skimmer. The pool elevation can be controlled by adding or removing stop logs. The discharge structure connects to a 24-inch diameter smooth walled metal pipe underground conveyance.

2.0 GEOLOGY

The site lies in the Western Kentucky Coalfields, a gently rolling upland. In the vicinity of the site, maximum topographic relief is on the order of 80 feet. Surface drainage is to the south to Groves Creek, a primary tributary to the Green River, and to the east to the Green River.

Published geologic mapping (Murphy, 2007) shows the site to be immediately underlain by unconsolidated loess representing the Pleistocene and Holocene geologic epoch and unconsolidated alluvium representing the Pleistocene and Holocene epochs. The loess reportedly consists of sandy and clayey silt. The alluvium reportedly consists of silt and clay with lesser amounts of sand and gravel.

The unconsolidated materials are shown to be underlain by the base of the Shelburn Formation (formerly identified as the Lisman Formation (Fairer, 1973) and the Carbondale Formation, both of which represent the Pennsylvanian Geologic Period. The West Franklin Member consists of

one to three layers of limestone interbedded by calcareous clay shale, and comprises the top of the Shelburn Formation. The Providence Limestone Member, consisting of limestone and interbedded shale, comprises the base of the Shelburn Formation. The Providence Limestone Member is reportedly absent in much of the area due to erosional channeling. Due to its discontinuous character and the presence of interbedded shale, hydrologically significant karst features are not present in the Providence Limestone Member. The underlying Carbondale Formation consists of cyclic sequences of sandstones, shales, siltstones and coals. The Carbondale sediments were deposited in a fluvial-deltaic system. As a result of this depositional environment, the lithologic units of the Carbondale tend to be lenticular bodies rather than continuous sheet-like strata. Gradational and abrupt horizontal changes in lithology are often encountered.

The structure contours illustrated on the geologic map (Murphy, 2007) are based on the altitude of the No. 9 coal seam, and show the site to lie on the flank of a gentle anticline. Stratigraphic dip is shown to be on the order of 35 feet per mile to the southeast. No faults or other significant structural features are depicted on the geologic map.

3.0 HYDROGEOLOGY

The stratigraphic interval considered as the most prominent water transmitting zone within and adjacent to the Sebree Generating Station is material identified as the Upper Sandstone Member (Sebree sandstone) of the Carbondale Formation. The United States Geologic Survey (USGS) Geologic Map of the Robards Quadrangle describes the Sebree sandstone sequence as "Siltstone, sandstone, shale and coal: Siltstone, light- to medium-gray, micaceous, thin-bedded, and locally calcareous. Sandstone, light- to medium-gray, grayish- and yellowish-brown, fine- to medium-grained slightly micaceous, thin-bedded to massive; locally fills channels."

For purposes of compliance with the CCR Rule groundwater monitoring requirements; this sequence, and in particular the member sandstone intervals, is considered to be the uppermost aquifer underlying the Reid/HMPL CCR Surface Impoundment.

The sandstone units in the upper Carbondale Formation reportedly can provide well yields of 500 gallons per day (gpd) or greater with some reported yields on the order of 30 gallons per minute [gpm] (Maxwell and Devaul, 1962). The Providence Limestone Member of the Shelburn Formation is reported to yield little to no water to wells. The lower Carbondale Formation, above and below the No. 9 coal seam, consists primarily of shales that reportedly yield little to no water to wells. Previous site-specific investigations, by others, have noted the presence of perched zones of saturation in the overlying unconsolidated materials.

3.1 Groundwater Monitoring System

Five temporary piezometers (P-13/P-13A, P-14 and P-15/P-15A) were installed adjacent to and respectively; northwest, southeast and southwest of the Reid/HMPL CCR impoundment to determine general direction of groundwater movement. Measured static water levels, from the highest to lowest elevation were observed in P-13/13A (highest), P-14 and P-15/P-15A (lowest) resulting in a calculated hydraulic gradient or apparent direction of groundwater movement is generally from east-northeast to west-southwest. This groundwater gradient characterization

and the ability to locate monitoring wells specific to the CCR unit justify the placement of the minimum of one upgradient and three down-gradient monitoring wells. The upgradient monitoring well (MW-7) was installed adjacent to, and east-northeast of the impoundment. The downgradient monitoring wells (MW-8, MW-9 and MW-10) were installed adjacent to, and respectively; west, southwest and south-southwest of the impoundment. All monitoring wells are completed in the stratigraphic interval described above. Approximate locations of the groundwater monitoring wells are shown on the Groundwater Monitoring Well Location Aerial Photo (**Attachment B**). Boring logs and well construction diagrams are presented as **Attachment C**.

3.2 Groundwater Flow

Water level data were collected from the unit during the nine baseline CCR monitoring events from March 2016 through October 2017 as summarized on **Table 1 of Attachment A**.

These data and the piezometric surface map presented below (**Figure 3**) represent general conditions at the Surface Impoundment and support the following analysis.

Overall groundwater flow beneath the footprint of the Reid/HMPL Surface Impoundment is to the southwest towards an unnamed tributary to Groves Creek located west/southwest of the impoundment. The hydraulic gradients calculated during the baseline period ranged from 0.0251 to 0.0258 towards the southwest as presented in **Table 2 of Attachment A**.

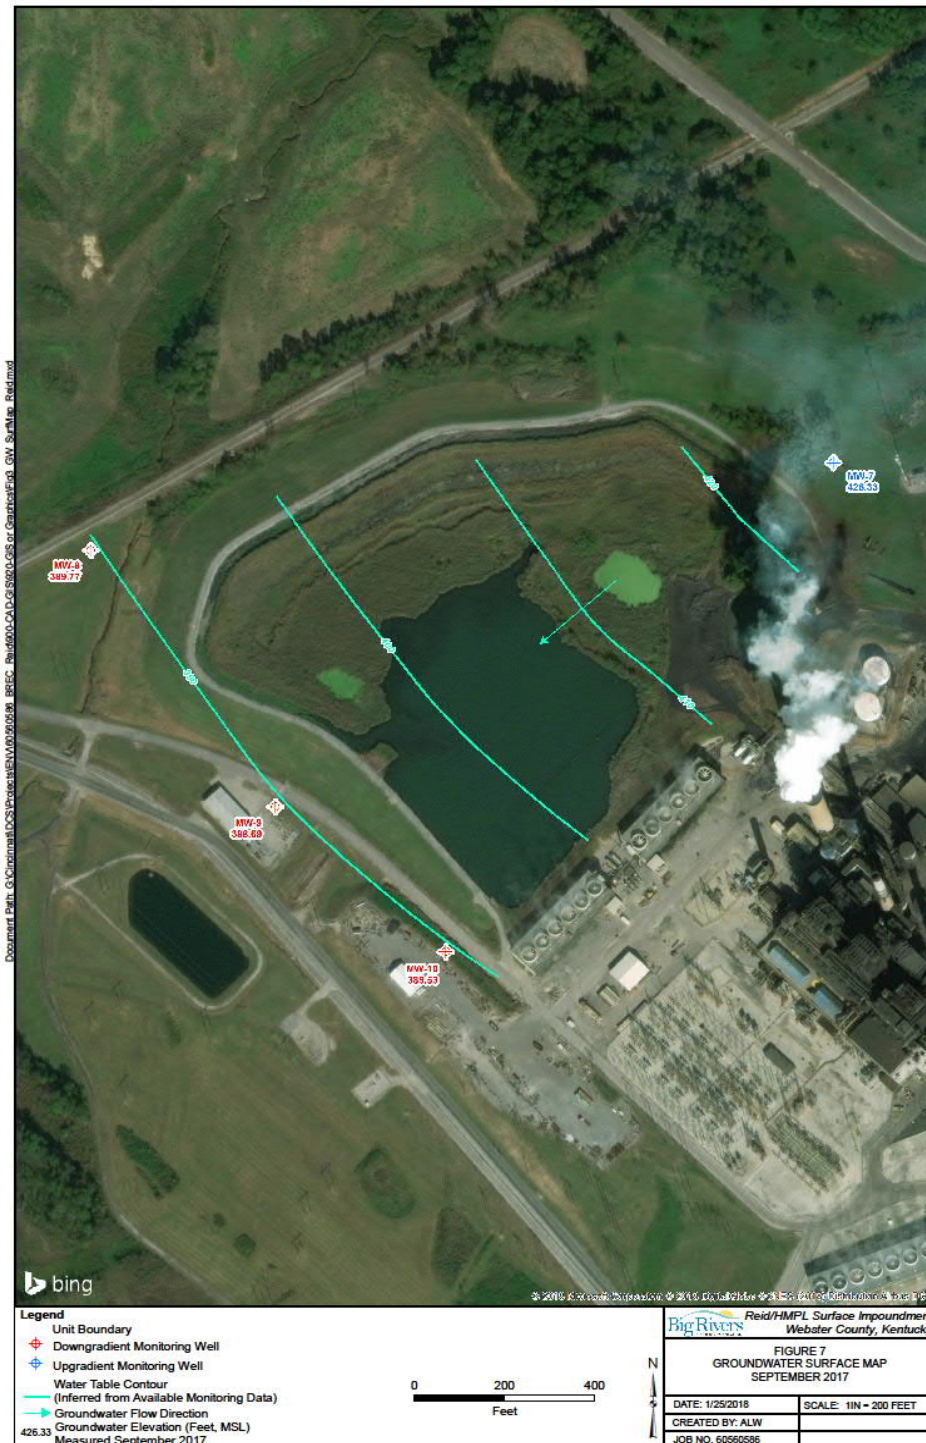


Figure 3: Reid/HMPL Surface Impoundment - Piezometric Surface Map

4.0 UPPERMOST AQUIFER

The “uppermost aquifer” is defined by 40 CFR §257.40 as the geologic formation nearest the natural ground surface that is an aquifer, as well as lower aquifers that are hydraulically interconnected with this aquifer within the facility’s property boundary. This definition includes a shallow, deep, perched, confined or unconfined aquifer, provided it yields usable water.

4.1 Aquifer Characteristics

Site-specific data pertaining to the aquifer characteristics beneath the Reid/HMPL Surface Impoundment were obtained prior to initiation of this CCR Program.

Available information pertaining to the sandstone units in the upper Carbondale Formation, identified as the uppermost aquifer beneath the Surface Impoundment, generally provide well yields of 500 gpd or greater with some reported yields on the order of 30 gpm (Maxwell and Devaul, 1962). The Providence Limestone Member of the Shelburn Formation is reported to yield little to no water to wells. The lower Carbondale Formation, above and below the No. 9 coal seam, consists primarily of shales that reportedly yield little to no water to wells. Previous site-specific investigations, by others, have noted the presence of perched zones of saturation in the overlying unconsolidated materials.

4.2 Placement Above the Uppermost Aquifer

Based on the available boring logs from the CCR Rule monitoring well system, the top of the upper Carbondale Formation (uppermost aquifer) is at an approximately elevation of 413.4 feet to the northeast (at MW-7), 384.2 feet to the south (at MW-10), 364.4 feet to the southwest (at MW-9), and 341.6 feet to the west (at MW-8) of the Surface Impoundment. Illustrated well boring cross-sections located adjacent to the Surface Impoundment are presented as **Attachment B**. Although it is not directly evidenced whether the base of the Surface Impoundment (389.2 feet in the western corner and approximately 400 feet in the northeast corner) intercepts or encroaches on the 5 foot separation from the top of the upper Carbondale Formation (uppermost aquifer) in the vicinity of monitoring well MW-7, hydraulic connectivity cannot be disproven based on available groundwater surface data discussed below.

Groundwater data provided by BREC via baseline data collection from monitoring wells between March 2016 and October 2017 were used to interpret the elevations of the uppermost aquifer within the area of the Surface Impoundment. Seasonal measurements (March, May, August, October 2016, and January 2017) are presented within the Groundwater Elevation Summary located as **Attachment B**. Based on the cross sections presented in **Attachment B**, the potentiometric surface is approximately 0.5 and 2 feet above the lowest base of the Surface Impoundment (389.2 feet at the west corner) and averaging approximately 28 feet above the Surface Impoundment base of approximately 400 feet at the northeast corner.

5.0 CONCLUSIONS

Available data regarding site groundwater, site geology, and physical limits of the unit for the Reid/HMPL Surface Impoundment do not evidence a 5-foot separation between the base of the impoundment and the uppermost limit of the uppermost aquifer and they do not support a lack of hydraulic connectivity between the unit and the aquifer as specified in 40 CFR §257.60(a). Therefore the unit does not meet the Placement above the Uppermost Aquifer requirement of 40 CFR §257.60(a).

6.0 REFERENCES

Burns and Roe, Inc., Engineering and Consultants, June 30, 1978, Site Grading Plans.

Fairer, G.M., Geologic Map of the Robards Quadrangle, Henderson and Webster Counties, Kentucky, U.S. Geological Survey, 1973.

Geotechnical and other information provided by Associated Engineers, Inc.

Engineering design drawings and other information provided by Big Rivers Electric Corporation

Maxwell, B.W. and Devaul, R.W., Availability of Ground Water in Hopkins and Webster Counties, Kentucky, U.S. Geological Survey, 1962.

Murphy, 2007. Geological mapping.

United States Geological Survey U.S. Geological Survey (USGS) 7.5 minute Robards and Delaware topographic quadrangle maps

Attachments

Attachment A
Tables 1 and 2

TABLE 1

**MONITORING WELL NETWORK GROUNDWATER ELEVATIONS - MARCH 2016 - OCTOBER 2017
REID/HMPL STATION SURFACE IMPOUNDMENT**

**BIG RIVERS ELECTRIC CORPORATION
SEBREE STATION
WEBSTER COUNTY, KENTUCKY**

Reference Elevation TOIC*(ft, NAD27)	GROUNDWATER MONITORING WELL NETWORK							
	MW-7		MW-8		MW-9		MW-10	
	Upgradient/Background 444.43		Downgradient 394.29		Downgradient 395.40		Downgradient 422.27	
Date Measured	Depth to Water (ft) (feet)	GW Elevation (feet)	Depth to Water (ft) (feet)	GW Elevation (feet)	Depth to Water (ft) (feet)	GW Elevation (feet)	Depth to Water (ft) (feet)	GW Elevation (feet)
3/30/2016	14.93	429.5	1.64	392.65	3.44	391.96	31.71	390.56
5/31/2016	14.91	429.52	1.41	392.88	3.28	392.12	29.60	392.67
8/23/2016	15.75	428.68	1.42	392.87	3.56	391.84	29.96	392.31
10/18/2016	16.77	427.66	2.38	391.91	4.49	390.91	30.63	391.64
1/31/2017	15.59	428.84	1.94	392.35	4.16	391.24	30.63	391.64
2/9/2017	15.81	428.62	2.12	392.17	4.52	390.88	30.63	391.64
5/11/2017	15.73	428.70	1.74	392.55	4.05	391.35	30.20	392.07
8/23/2017	17.72	426.71	4.16	390.13	6.46	388.94	32.46	389.81
9/22/2017	18.10	426.33	4.52	389.77	6.71	388.69	32.74	389.53
10/11/2017	18.16	426.27	4.67	389.62	6.9	388.50	32.90	389.37

*Reference elevation of monitoring wells surveyed by Associated Engineers, Inc., Madisonville, Kentucky, January 2015
Survey coordinates were based on the Kentucky State Plane, Kentucky Southern Zone, NAD27 datum
TOIC = Top of internal casing
GW = Groundwater; GS = Ground Surface; NM = Not measured

TABLE 2

**HYDRAULIC GRADIENT
GROUNDWATER MONITORING SYSTEM**

**BIG RIVERS ELECTRIC CORPORATION - SEBREE STATION
REID/HMPL STATION SURFACE IMPOUNDMENT
WEBSTER COUNTY, KENTUCKY**





	Well ID / GW Elevation (ft, NAD27)		Change in Head (feet)	Horizontal Distance* (feet)	Hydraulic Gradient
	MW-7	MW-9			
Mar 2016	429.50	391.96	37.54	1466	0.0256
May 2016	429.52	392.12	37.40	1466	0.0255
Aug 2016	428.68	391.84	36.84	1466	0.0251
Oct 2016	427.66	390.91	36.75	1466	0.0251
Jan 2017	428.84	391.24	37.60	1466	0.0256
May 2017	428.70	391.35	37.35	1466	0.0255
Aug 2017	426.71	388.94	37.77	1466	0.0258
Sept 2017	426.33	388.69	37.64	1466	0.0257
Oct 2017	426.27	388.50	37.77	1466	0.0258

*Reference elevation of monitoring wells surveyed by Associated Engineers, Inc.,
Madisonville, Kentucky, January 2015

Survey coordinates were based on the Kentucky State Plane, Kentucky Southern Zone, NAD27 datum

*Horizontal distance between monitoring wells, parallel to the direction of groundwater flow
(as determined by measurements utilizing Kentucky GIS)

Attachment B
Groundwater Elevation Summary

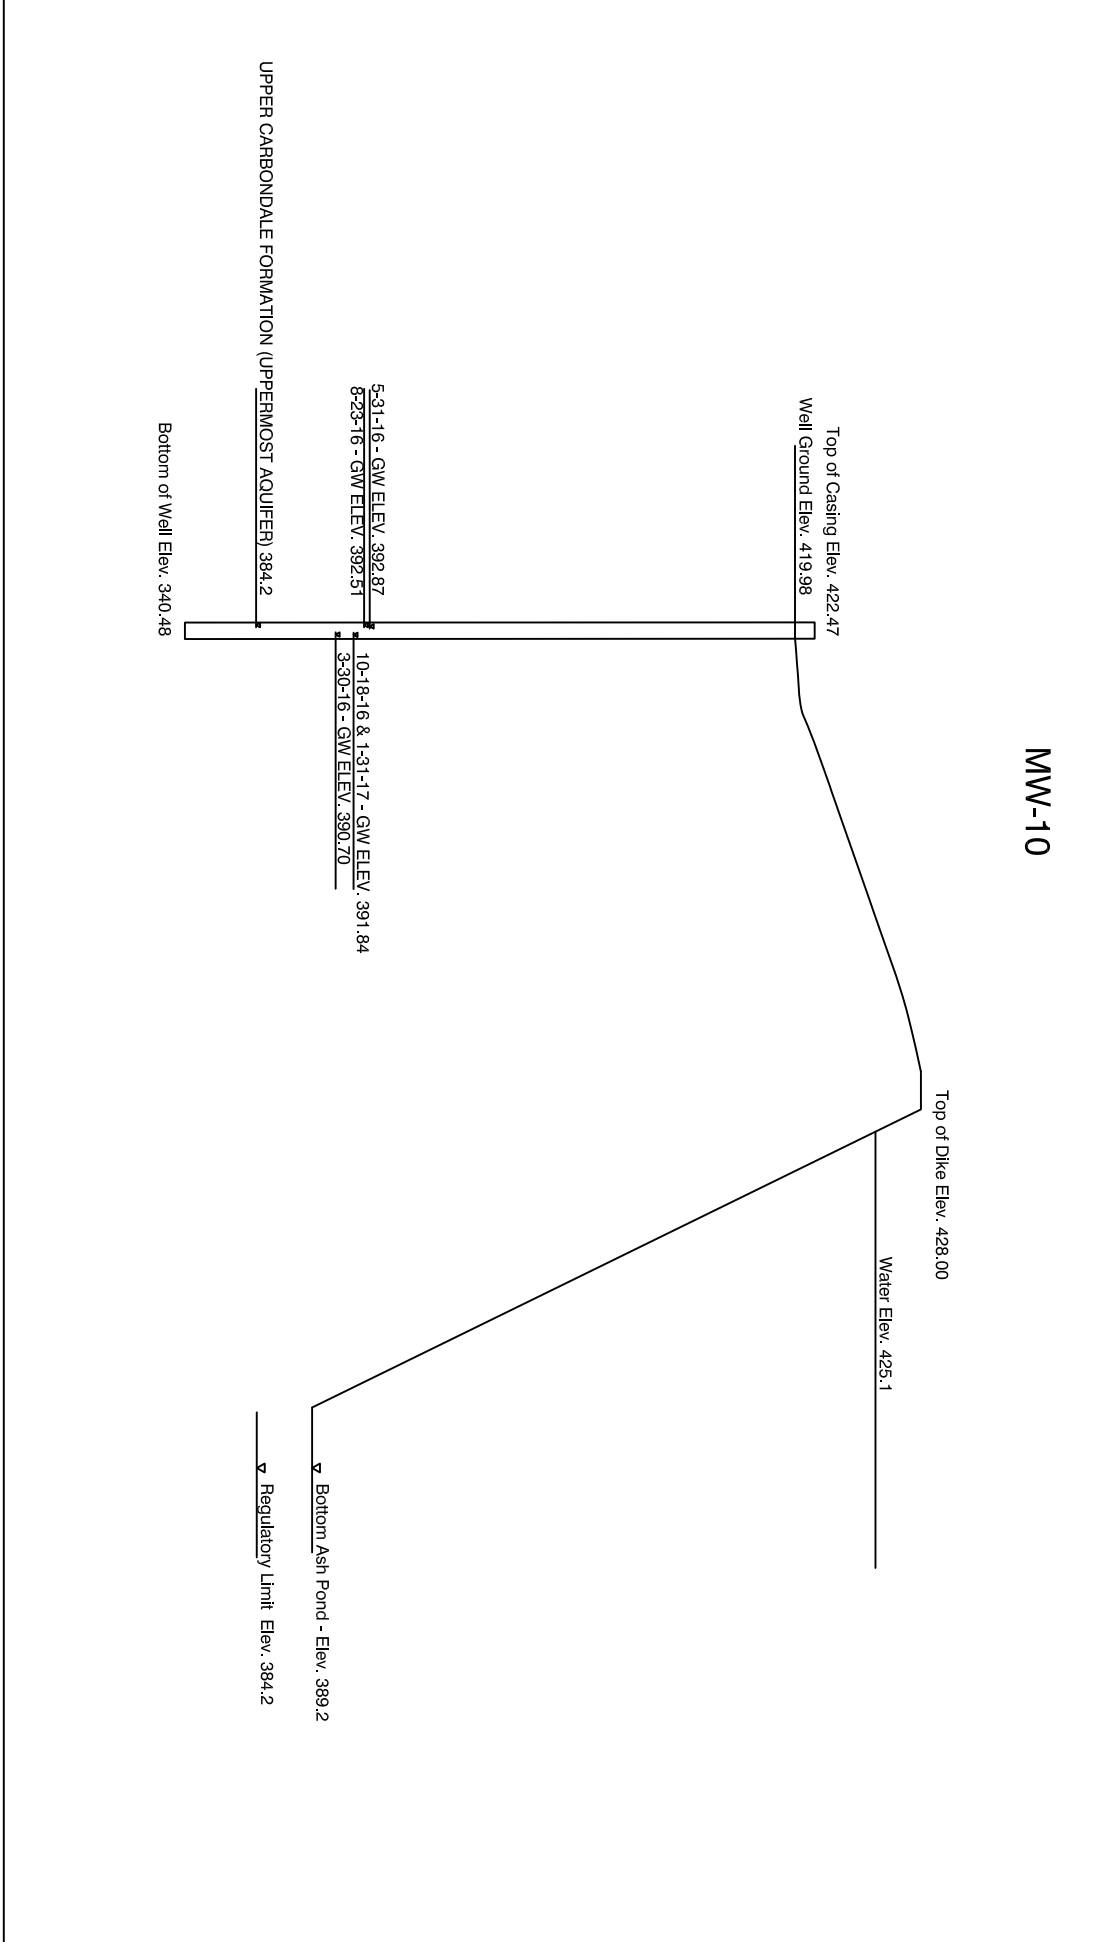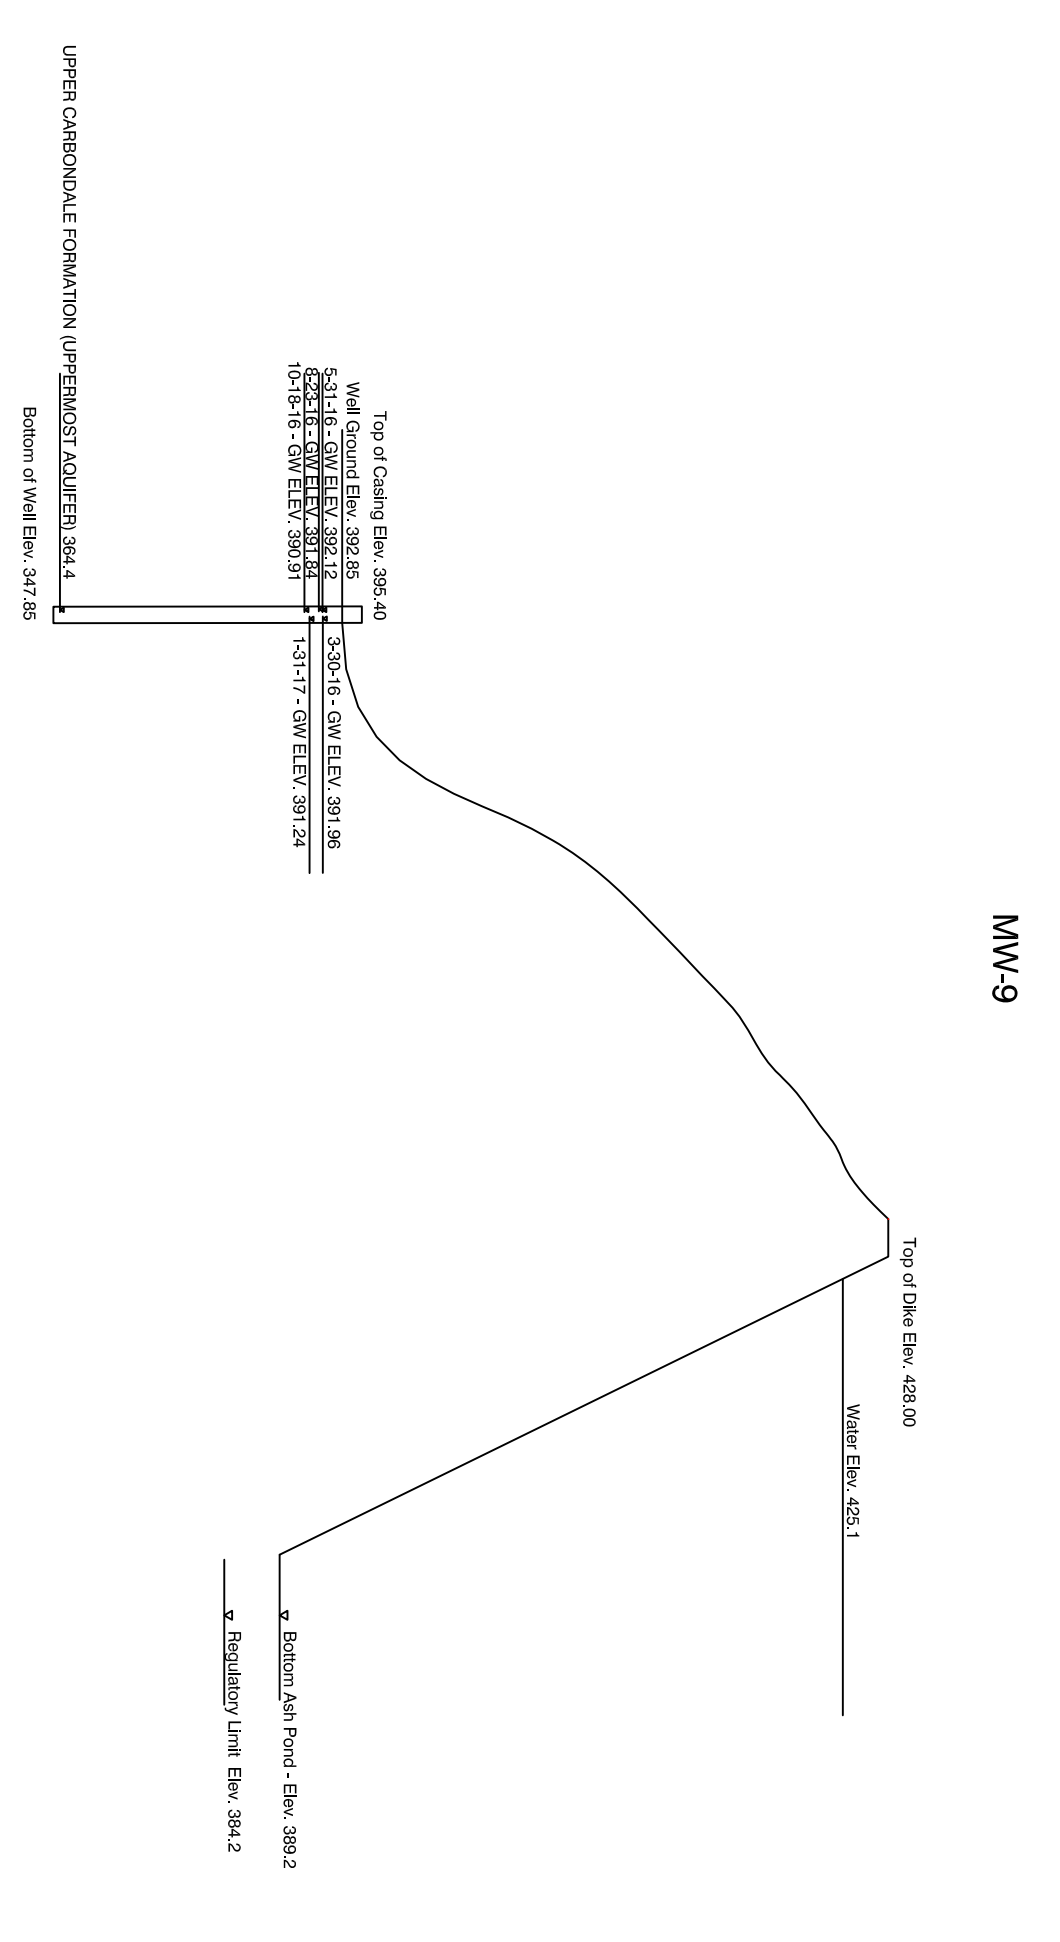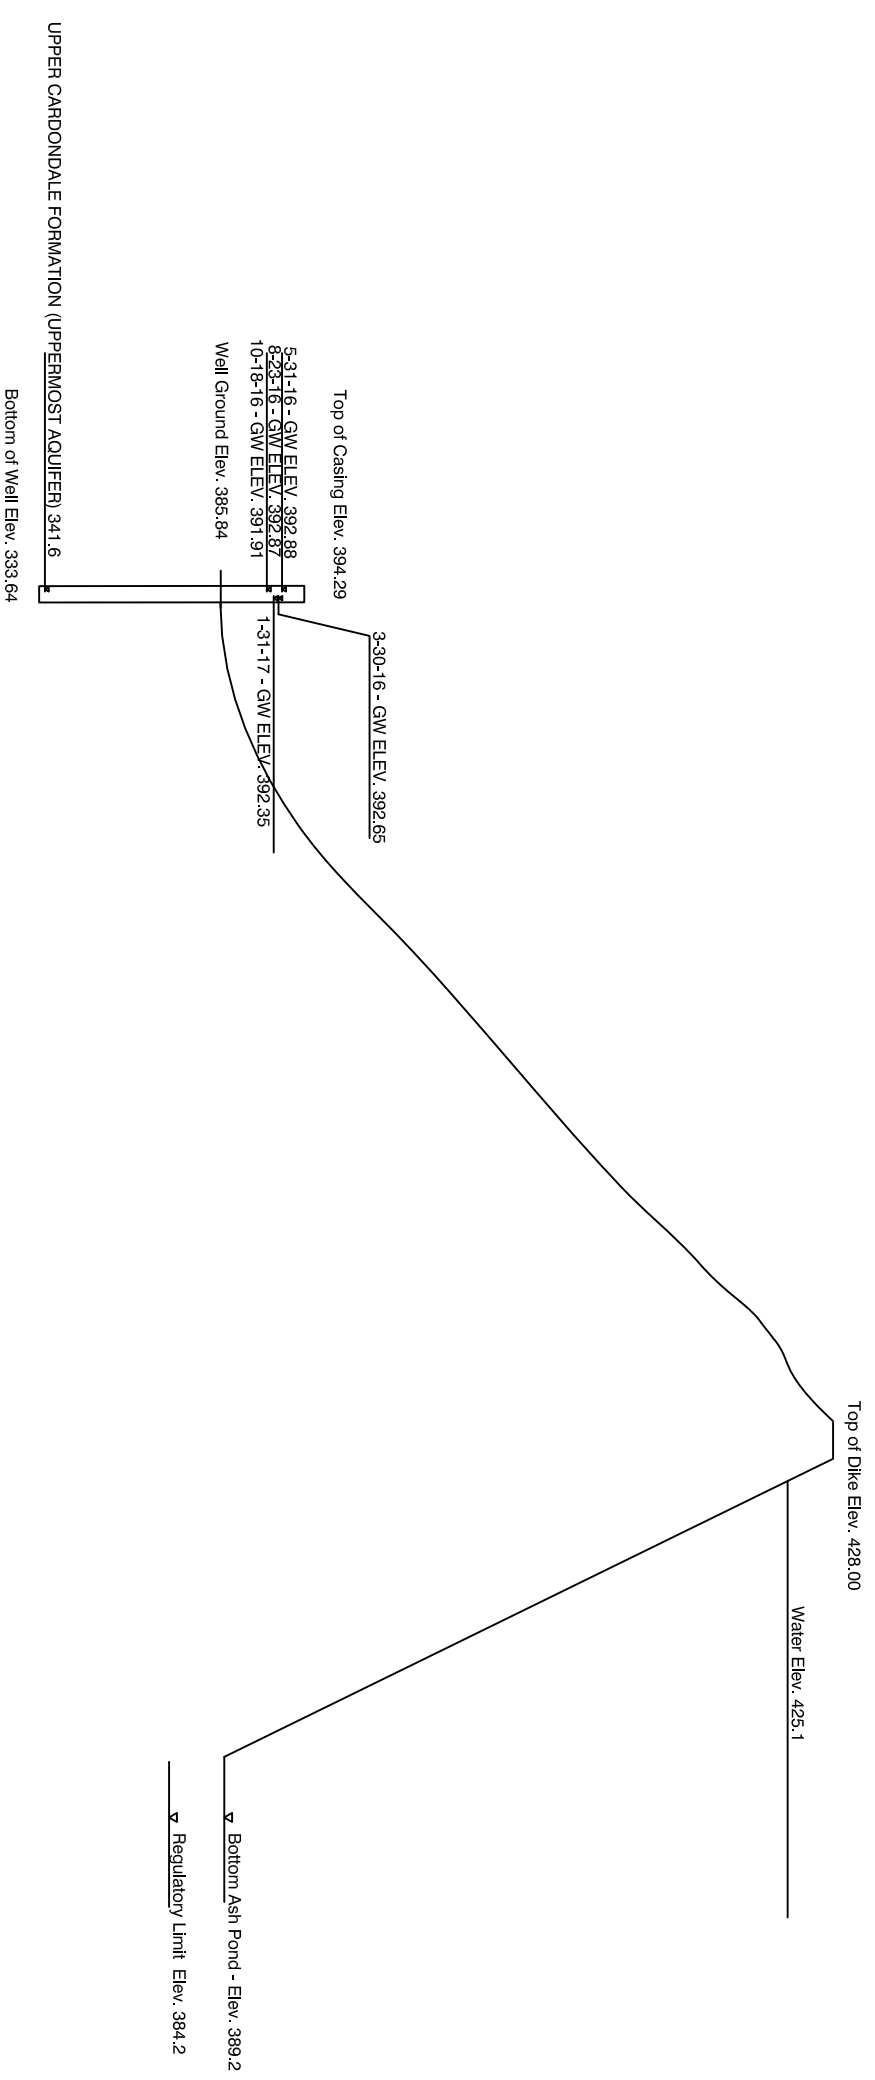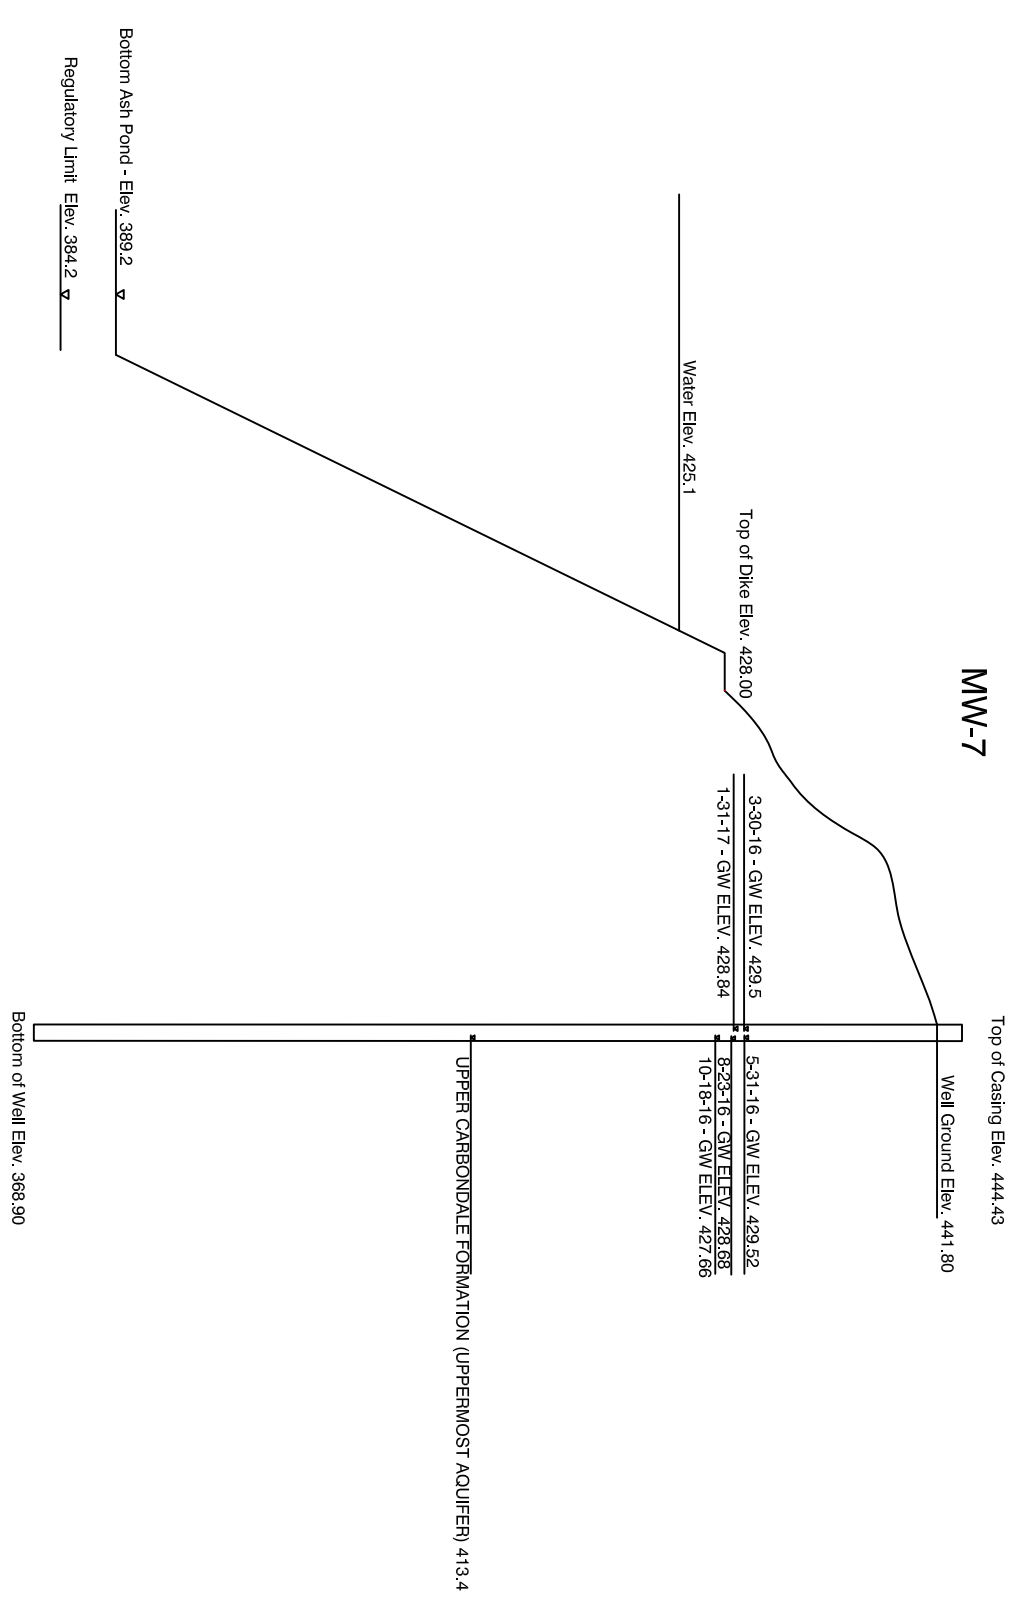

REID/HMPL COAL COMBUSTION RESIDUALS SURFACE IMPOUNDMENT GROUNDWATER ELEVATION SUMMARY

Monitoring Well ID	Well Ground Elevation (feet, NAD27)	Top of Well Casing (feet, NAD27)	Total Well Depth (feet, TOIC)	Bottom of Well Elevation (feet, NAD27)	Depth to Top of Screened Interval (feet, GS)	Top of Screened Elevation (feet, NAD27)	Depth to Bottom of Screened Interval (feet, GS)	Bottom of Screened Elevation (feet, NAD27)	Bottom of Ash Pond Elevation	Depth to Water (feet, TOIC)	3/30/2016		5/31/2016		10/18/2016	GW Elevation (feet, NAD27)	Depth to Water (feet, TOIC)	GW Elevation (feet, NAD27)	Depth to Water (feet, TOIC)	GW Elevation (feet, NAD27)	Depth to Water (feet, TOIC)	GW Elevation (feet, NAD27)		
											GW Elevation (feet, NAD27)	Depth to Water (feet, TOIC)	GW Elevation (feet, NAD27)	Depth to Water (feet, TOIC)										
MW-7	441.80	444.43	75.5	368.90	67.9	373.90	72.9	368.90			429.50	14.91	429.52	15.75	428.68	16.77	427.66	15.59	428.84					
MW-8	385.84	394.29	60.7	333.64	47.2	338.64	52.2	333.64			397.65	1.41	392.88	1.42	392.87	2.38	391.91	1.94	392.35					
MW-9	392.85	395.40	47.6	347.85	35.0	357.85	45.0	347.85	389.2	14.93	391.96	3.28	392.12	3.56	391.84	4.49	390.91	4.16	391.24					
MW-10	419.98	422.47	82.0	340.48	69.5	350.48	79.5	340.48			390.70	29.6	392.87	29.96	392.51	30.63	391.84	30.63	391.84					

Attachment C

Boring Logs and Well Construction Diagrams

UNIFORM KENTUCKY WELL CONSTRUCTION RECORD

Use this form only to report installation of monitoring or water wells.
 Original copy must be submitted to Division of Water within 60 days of completion.
 See instructions on reverse of form.
 Record must be typed or neatly printed or it will be returned to the driller as unacceptable.
 One copy to Division of Water, one copy to owner, one copy to driller's files.



4. Owner name: Big Rivers Electric Corporation
 5. Owner address: 201 Third Street
 6. City: Henderson
 7. State: KY
 8. Zip: 42420
 If site name and address differ from owner name and address:
 9. Site name: Sebree Station
 10. Site address: 9000 Highway 2096
 11. City: Robards
 12. State: KY
 13. Zip: 42452

1. Kentucky Well ID (AKGWA) Number: 8006 - 3934
 2. Owner well ID#: MW-7
 3. Attachments Required:
 1. Site plan or sketch map
 2. Well location:
 On topographic map, OR
 Obtained by GPS unit
 Conditionally Required:
 3. Well diagram (monitoring well)
 4. Coliform analysis (if applicable)
 5. Signed Variance (if applicable)
 Optional:
 6. Other laboratory analysis report

14. Agency Interest (AI) Number: 4196
 15. Facility type: CERCLA Solid Waste Drinking Water
 & RCRA UST Mining
 ID Number: CCR Rule

16. Owner phone: 270 - 844 - 6031
 17. Site phone: 270 - 521 - 7927

18. USGS topo map: Robards
 19. County: Henderson
 20. Physiographic Region: Blue Grass Ohio River Alluvium
 E. Coal Field W. Coal Field
 Miss. Plateau Jackson Purchase
 21. Surface elevation (ft): 441.8
 22. Elevation determined by: GPS Map Prior report
 Survey Prior well log

23. Install start date: 12 / 4 / 15
 24. Install end date: 1 / 6 / 15
 Please report depths in feet below ground surface, not as relative elevations.
 25. Total depth: 73.4
 26. Depth to bedrock: 24.1
 27. Static water level: 12.30
 28. Casing height above surface (in): 31.56

29. Well use: Agriculture Commercial Domestic Industrial Monitoring / Remed Public
 Geothermal Heat pump HVAC Injection Mining Unused
 NOTE: CODE REQUIRED for most well uses. See back of form for codes.
 30. Drilling method: Auger - HS Auger - SS Auger - bucket Auger - hand Cable tool Core Driven Casing Excavation Combined - HS auger and air rotary Combined - other (specify):
 Jet wash Push/probe Rotary - air Rotary - mud Rotary - reverse Sand point Sonic Unknown
 31. Well status: Active Inactive Unsuitable for intended use
 32. Wellhead: Flush Well cap Locking Sanitary seal
 33. Well development method: Surging Jetting Pumping Backwashing Bailing Compressed air Combination of methods (specify): Air-lift pump and water flush

WATER WELLS ONLY
 34. Estimated well yield: gpm gph gpd
 35. Well service: # of people served

46. Well completion: Casing and screens

From depth (feet)	To depth (feet)	Borehole diameter (inches)	Casing diam (in) ID/OD	Casing type	Screen slot size
0.0	28.4	10.5	2.0 / 2.38	Sch 40 PVC	
28.4	67.9	6.5	2.0 / 2.38	Sch 40 PVC	
67.9	72.9	6.5	2.0 / 2.38	Sch 40 Screen	0.010

47. Annulus fill and seal

From depth (feet)	To depth (feet)	Material
0.0	2.0	Concrete
2.0	63.9	Cement grout
63.9	65.9	Bentonite pellets
65.9	73.4	Silica sand

36. Disinfectant amount: oz qt cups lb gal
 37. Type: Bleach Hypochlorite
 38. Pitless adapter installed: Yes No
 39. Pump installed: Submersible Jet Turbine Hand No pump
 Bailer or bucket

48. Lithologic log (if more space is needed, continue on separate page)

From depth (ft)	To depth (ft)	Description (include any show of water and indicate apparent quality)
		See attachment

49. Sketch map: See attachment

40. Depth to intake (ft):
 41. Apparent quality and odor:
 APPEARANCE: Clear Cloudy Muddy Turbid
 ODOR: Iron Slight mod. high
 Iron Sulfur Salt
COLIFORM TEST
 42. Coliform test type: fecal fecal and total
 43. Coliform test results: 0 or <1.0 TNTC Confluent
 or # colonies per 100 mL
 44. Date sampled: Month / Day / Year
 45. Date analyzed:

50. Comments: 4 1/4" ID HSA followed by 10 1/2" drag bit advanced to 28.4'. 8" ID PVC casing set to 28.4'. 6 1/2" tricone bit advanced to 73.4'. Silica sand set 72.9'-73.4'. 2" casing and screen set. Sand placed 65.9'-72.9'. Bentonite pellets set 63.9'-65.9'. After minimum 8 hour hydration time, cement grout set 28.4'-63.9' using tremie method. 8" casing pulled and grouting continued to 2'. Protective surface casing and pad installed after grout cured.


Latitude: 37.649307
 Longitude: -87.503061
 Lat/Long Method: INT GPS SUR REP
 Date Received:

51. Affirmation: The work described above was done under my supervision, and this report is true and correct to the best of my knowledge. Note: the driller is not responsible for natural groundwater quality or quantity encountered while drilling or completing this well.
 Signature of certified driller: [Signature]
 Date signed: 5/25/16
 Certification number: 0219-0364-00
 Drilling company: Associated Engineers, Inc.

48. Lithologic Log MW-7

From depth (ft)	To depth (ft)	Description
0.0	6.5	Silty clay brown
6.5	11.7	Silty clay brown, moist
11.7	12.9	Silty clay yellowish brown moist
12.9	15.5	Sandy clay yellowish brown moist
15.5	18.8	Sandy clay yellowish brown moist
18.8	24.1	Silty sand yellowish brown wet
24.1	28.4	Sandstone yellowish brown weathered
	28.4	Auger refusal
28.4	33.8	Sandstone yellowish brown weathered
33.8	37.3	Shale dark gray
37.3	49.8	Shale gray soft
49.8	51.4	Shale w/interbedded shale gray soft
51.4	55.3	Sandstone gray hard
55.3	57.6	Sandstone w/sandy shale streaks gray
57.6	63.4	Sandy shale gray
63.4	66.7	Shale gray
66.7	67.0	Sandy shale gray
67.0	67.5	Shale gray w/interbedded sandstone
67.5	73.4	Sandstone gray
	73.4	TD

MONITORING WELL 8006-3934 (MW-7)

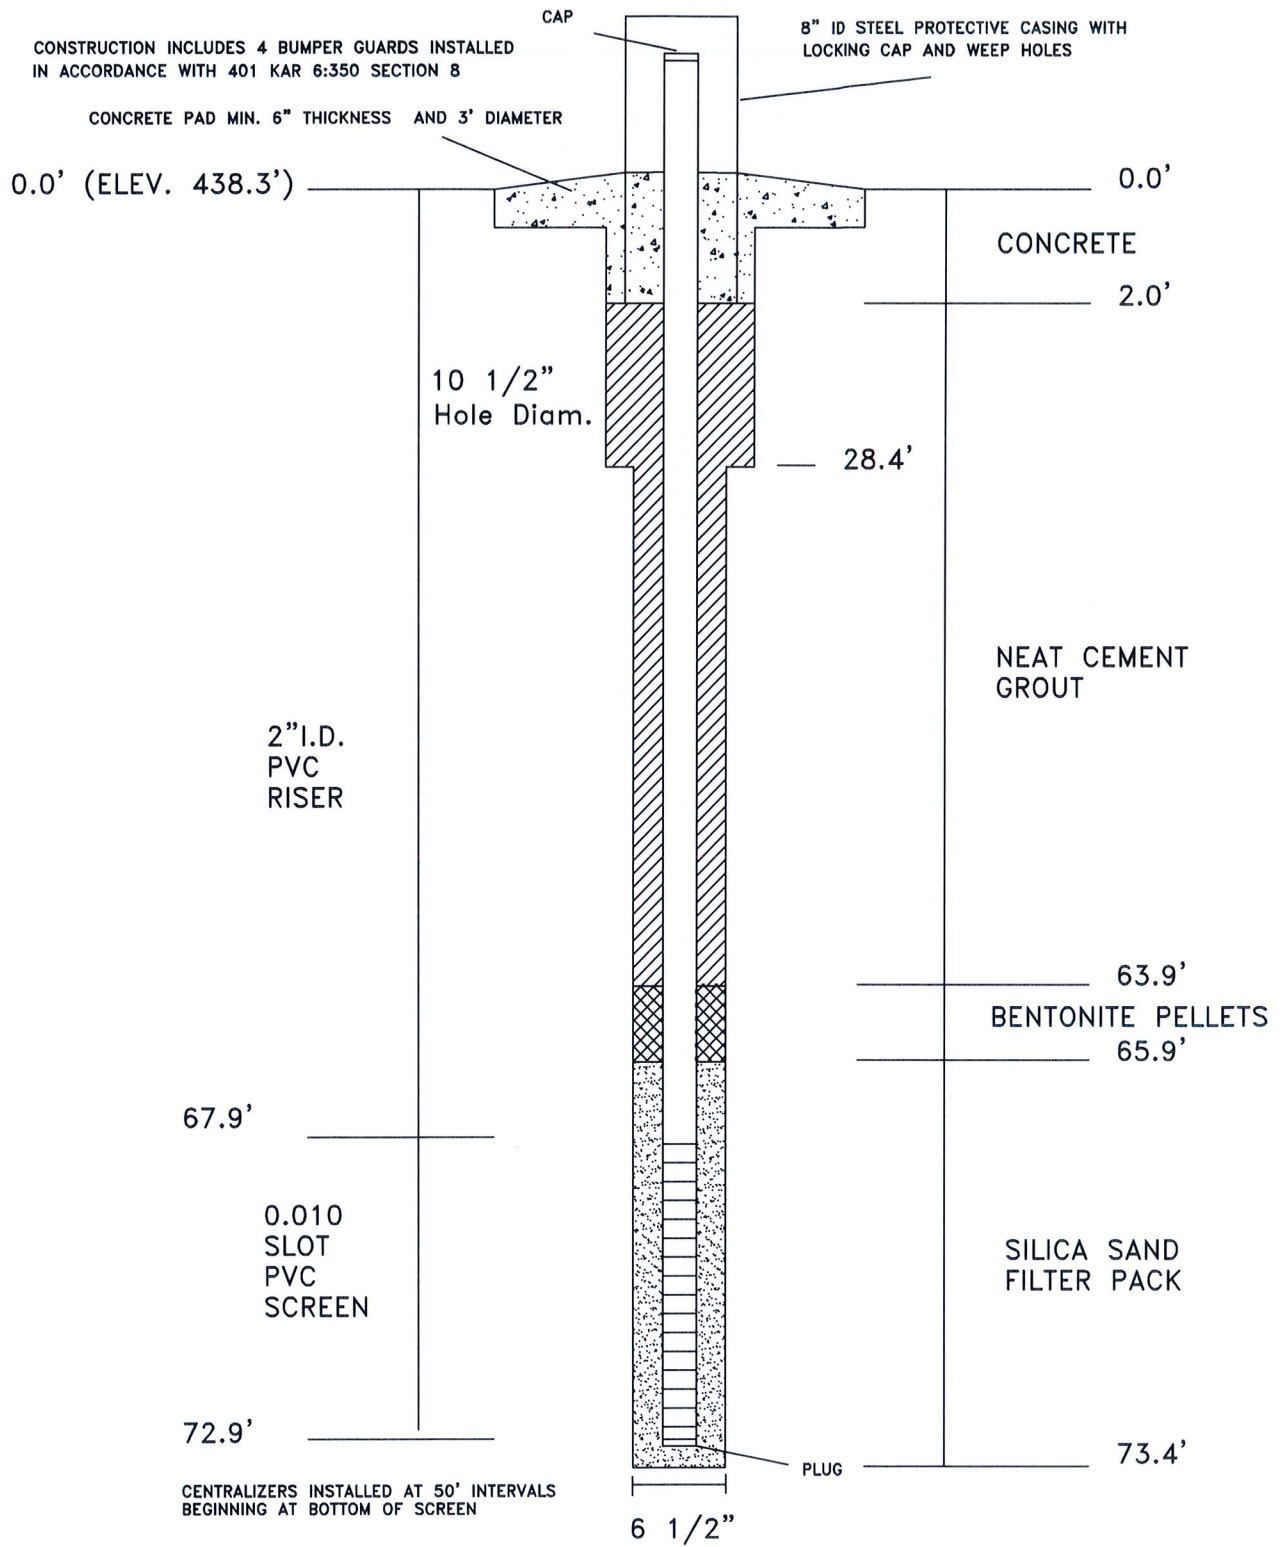

BIG RIVERS ELECTRIC CORPORATION

Well Construction Diagram

Job Number:	15-0140F	Revisions:
Date:	12/28/15	
Scale:	No Scale	
Drawn By:	D. Dunbar	

ASSOCIATED ENGINEERS, INC.

2740 North Main St. · Madisonville, KY 42431
 Phone: (270) 821-7732 · Fax: (270) 821-7789
www.associatedengineers.com

UNIFORM KENTUCKY WELL CONSTRUCTION RECORD

Use this form only to report installation of monitoring or water wells.
 Original copy must be submitted to Division of Water within 60 days of completion.
 See instructions on reverse of form.
 Record must be typed or neatly printed or it will be returned to the driller as unacceptable.
 One copy to Division of Water, one copy to owner, one copy to driller's files.

Attach Well Identification Number (AKGWA) Label Here

Water wells: yellow labels
 Monitoring wells: blue labels

4. Owner name: Big Rivers Electric Corporation
 5. Owner address: 201 Third Street
 6. City: Henderson State: KY Zip: 42420
 7. State: KY 8. Zip: 42420
 If site name and address differ from owner name and address:
 9. Site name: Sebree Station
 10. Site address: 9000 Highway 2096
 11. City: Robards State: KY Zip: 42452

1. Kentucky Well ID (AKGWA) Number: 8006 - 3935
 2. Owner well ID#: MW-8
 3. Attachments Required:
 1. Site plan or sketch map
 2. Well location:
 On topographic map, OR
 Obtained by GPS unit
 Conditionally Required:
 3. Well diagram (monitoring well)
 4. Coliform analysis (if applicable)
 5. Signed Variance (if applicable)
 Optional:
 6. Other laboratory analysis report

14. Agency Interest (AI) Number: 4196
 15. Facility type: CERCLA Solid Waste Drinking Water & RCRA UST Mining
 ID Number: CCR Rule
 16. Owner phone: 270 - 844 - 6031
 17. Site phone: 270 - 521 - 7927

18. USGS topo map: Robards
 19. County: Henderson
 20. Physiographic Region: Blue Grass Ohio River Alluvium E. Coal Field W. Coal Field Miss. Plateau Jackson Purchase
 21. Surface elevation (ft): 385.84
 22. Elevation determined by: GPS Map Prior report Survey Prior well log

23. Install start date: 12 / 10 / 15 (Month / Day / Year)
 24. Install end date: 07 / 06 / 16
 Please report depths in feet below ground surface, not as relative elevations.

25. Total depth: 54.2
 26. Depth to bedrock: 44.2
 27. Static water level: -6.81
 28. Casing height above surface (in): 105.24

29. Well use: Agriculture Commercial Domestic Industrial Monitoring / Remed Public
 Geothermal Heat pump HVAC Injection Mining Unused
 30. Drilling method: Auger - HS Auger - SS Auger - bucket Auger - hand Cable tool Core Driven Casing Excavation Combined - HS auger and air rotary Combined - other (specify):
 Jet wash Push/probe Rotary - air Rotary - mud Rotary - reverse Sand point Sonic Unknown
 31. Well status: Active Inactive Unsuitable for intended use
 32. Wellhead: Flush Well cap Locking Sanitary seal
 33. Well development method: Surging Jetting Pumping Backwashing Bailing Compressed air Combination of methods (specify):
 Air-lift pump and water flush
 NOTE: CODE REQUIRED for most well uses. See back of form for codes.

34. Estimated well yield: gpm gph gpd
 35. Well service: # of people served

46. Well completion: Casing and screens							47. Annulus fill and seal		
From depth (feet)	To depth (feet)	Borehole diameter (inches)	Casing diam (in) ID	Casing diam (in) OD	Casing type	Screen slot size	From depth (feet)	To depth (feet)	Material
0.0	44.2	10.5	2.0	2.38	Sch 40 PVC		0.0	2.0	Concrete
44.2	47.2	6.5	2.0	2.38	Sch 40 PVC		2.0	43.2	Cement grout
47.2	52.2	6.5	2.0	2.38	Sch 40 Screen	0.010	43.2	45.2	Bentonite pellets
							45.2	54.2	Silica sand

36. Disinfectant amount: oz qt cups lb gal
 37. Type: Bleach Hypochlorite
 38. Pitless adapter installed: Yes No
 39. Pump installed: Submersible Jet Turbine Hand Bailer or bucket No pump

40. Depth to intake (ft):
 41. Apparent quality and odor:
 APPEARANCE: Clear Cloudy Muddy Turbid
 ODOR: none slight mod. high
 Iron Sulfur Salt

42. Coliform test type: fecal fecal and total
 43. Coliform test results: 0 or <1.0 TNTC Confluent
 or # colonies per 100 mL

44. Date sampled: Month / Day / Year
 45. Date analyzed: Month / Day / Year

48. Lithologic log (if more space is needed, continue on separate page):
 From depth (ft): To depth (ft): Description (include any show of water and indicate apparent quality)
 See attachment
 49. Sketch map: See attachment

50. Comments: 4 1/4" ID HSA followed by 10 1/2" drag bit advanced to 44.2'. 8" ID PVC casing set to 44.2'. 6 1/2" tricone bit advanced to 54.2'. Silica sand set 52.2'-54.2'. 2" casing and screen set. Sand placed 45.2'-52.2'. Bentonite pellets set 44.2'-45.2'. Pellets set from 43.2' to 44.2 as casing pulled to 43.2. After 8 hour hydration time not able to pull 8" casing due to soil squeeze. Remaining annulus grouted with cement using tremie method. Pad installed after grout cured. Protective casing installed after artesian condition stabilized (See 6/22/16 variance request).
 Latitude: 37.648863
 Longitude: -87.508597


51. Affirmation: The work described above was done under my supervision, and this report is true and correct to the best of my knowledge. Note: the driller is not responsible for natural groundwater quality or quantity encountered while drilling or completing this well.
 Lat/Long Method: INT GPS SUR REP

Signature of certified driller: [Signature] Date signed: 08/31/16
 Certification number: 0219-0364-00 Drilling company: Associated Engineers, Inc.
 Date Received:

48. Lithologic Log MW-8

From depth (ft)	To depth (ft)	Description
0.0	0.3	Topsoil
0.3	3.0	Silty clay brown
3.0	7.0	Silty clay gray moist
7.0	10.0	Silty clay brown very moist
10.0	21.5	Silty clay brown wet
21.5	27.0	Silty clay gray wet
27.0	44.2	Silty clay w/gravel gray wet
	44.2	Auger refusal
44.2	48.4	Sandstone gray hard
48.4	49.5	Sandstone w/carbonaceous strks gray hard
49.5	51.0	Sandstone gray hard
51.0	51.8	Sandstone w/ shale strks gray
51.8	54.2	Sandy shale and interbedded sandstone gray
	54.2	TD

MONITORING WELL 8006-3935 (MW-8)

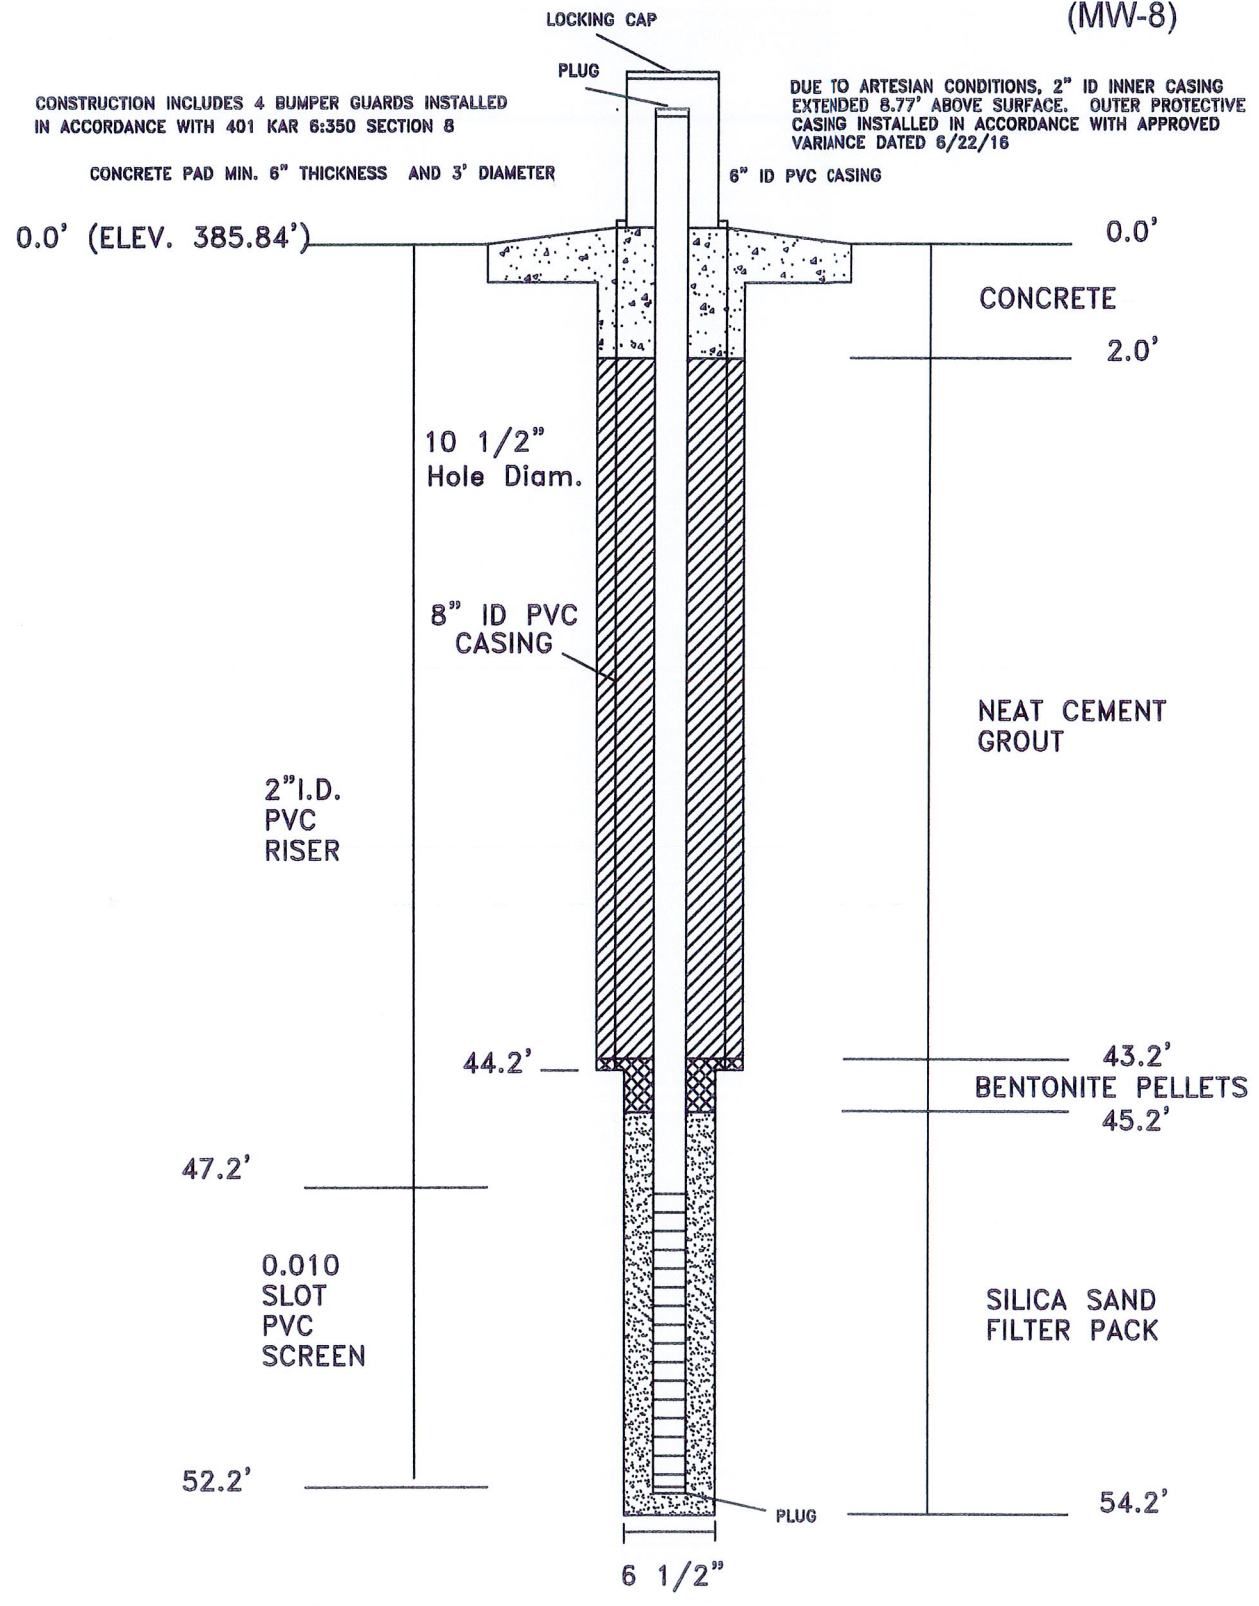

BIG RIVERS ELECTRIC CORPORATION

Well Construction Diagram

Job Number:	15-0140F	Revisions:
Date:	12/28/15	
Scale:	No Scale	
Drawn By:	D. Dunbar	

2740 North Main St. · Madisonville, KY 42431
 Phone: (270) 821-7732 · Fax: (270) 821-7789
www.associatedengineers.com

UNIFORM KENTUCKY WELL CONSTRUCTION RECORD

Use this form only to report installation of monitoring or water wells.
 Original copy must be submitted to Division of Water within 60 days of completion.
 See instructions on reverse of form.
 Record must be typed or neatly printed or it will be returned to the driller as unacceptable.
 One copy to Division of Water, one copy to owner, one copy to driller's files.



4. Owner name: Big Rivers Electric Corporation
 5. Owner address: 201 Third Street
 6. City: Henderson
 7. State: KY
 8. Zip: 42420
 If site name and address differ from owner name and address:
 9. Site name: Sebree Station
 10. Site address: 9000 Highway 2096
 11. City: Robards
 12. State: KY
 13. Zip: 42452

14. Agency Interest (AI) Number: 4196
 15. Facility type: CERCLA Solid Waste Drinking Water
 RCRA UST Mining
 ID Number: CCR Rule

16. Owner phone: 270 - 844 - 6031
 17. Site phone: 270 - 521 - 7927

18. USGS topo map: Robards
 19. County: Henderson
 20. Physiographic Region: Blue Grass Ohio River Alluvium
 E. Coal Field W. Coal Field
 Miss. Plateau Jackson Purchase
 21. Surface elevation (ft): 392.85
 22. Elevation determined by: GPS Map Prior report
 Survey Prior well log

29. Well use: Agriculture Geothermal Commercial Heat pump Domestic HVAC Industrial Injection Monitoring / Remed Mining Public Unused
 30. Drilling method: Auger - HS Jet wash Auger - SS Push/probe Auger - bucket Rotary - air Auger - hand Rotary - mud Cable tool Rotary - reverse Core Sand point Driven Casing Sonic Excavation Unknown Combined - HS auger and air rotary Combined - other (specify):
 31. Well status: Active Inactive Unsuitable for intended use
 32. Wellhead: Flush Well cap Locking Sanitary seal
 33. Well development method: Surging Jetting Pumping Backwashing Bailing Compressed air Combination of methods (specify): Air-lift pump and water flush

46. Well completion: Casing and screens

From depth (feet)	To depth (feet)	Borehole diameter (inches)	Casing diam (in) ID	OD	Casing type	Screen slot size
0.0	28.5	10.5	2.0	2.38	Sch 40 PVC	
28.5	35.0	6.5	2.0	2.38	Sch 40 PVC	
35.0	45.0	6.5	2.0	2.38	Sch 40 Screen	0.010

47. Annulus fill and seal

From depth (feet)	To depth (feet)	Material
0.0	2.0	Concrete
2.0	28.5	Cement grout
28.5	33.0	Bentonite pellets
33.0	56.3	Silica sand

48. Lithologic log (if more space is needed, continue on separate page)

From depth (ft)	To depth (ft)	Description (include any show of water and indicate apparent quality)
		See attachment

49. Sketch map: See attachment

50. Comments: 4 1/4" ID HSA followed by 10 1/2" drag bit advanced to 28.5'. 8" ID PVC casing set to 28.5'. 6 1/2" tricone bit advanced to 56.3'. Silica sand set 45.0'-56.3'. 2" casing and screen set. Sand placed 33.0'-45.0'. Bentonite pellets set 28.5'-33.0'. 8" casing pulled after minimum 8 hour hydration time. Hole grouted 2'-63.5'. Protective surface casing and pad installed after grout cured.

51. Affirmation: The work described above was done under my supervision, and this report is true and correct to the best of my knowledge. Note: the driller is not responsible for natural groundwater quality or quantity encountered while drilling or completing this well.

Signature of certified driller: [Signature]
 Date signed: 5/25/16
 Certification number: 0219-0364-00
 Drilling company: Associated Engineers, Inc.

1. Kentucky Well ID (AKGWA) Number: 8006 - 3936
 2. Owner well ID#: MW - 9

3. Attachments Required:
 1. Site plan or sketch map
 2. Well location: On topographic map, OR
 Obtained by GPS unit
 Conditionally Required:
 3. Well diagram (monitoring well)
 4. Coliform analysis (if applicable)
 5. Signed Variance (if applicable)
 Optional:
 6. Other laboratory analysis report

23. Install start date: 11 / 23 / 15
 24. Install end date: 11 / 25 / 15

Please report depths in feet below ground surface, not as relative elevations.
 25. Total depth: 56.3
 26. Depth to bedrock: 28.2
 27. Static water level: 0.89
 28. Casing height above surface (in): 30.60

WATER WELLS ONLY
 34. Estimated well yield: gpm gph gpd
 35. Well service: # of people served

36. Disinfectant amount: oz qt cups lb gal
 37. Type: Bleach Hypochlorite

38. Pitless adapter installed: Yes No
 39. Pump installed: Submersible Jet Turbine Hand Bailer or bucket No pump

40. Depth to intake (ft):
 41. Apparent quality and odor: Clear Cloudy Muddy Turbid
 ODOUR: none slight mod. high
 Iron Sulfur Salt

COLIFORM TEST
 42. Coliform test type: fecal fecal and total
 43. Coliform test results: 0 or <1.0 TNTC Confluent
 or # colonies per 100 mL

44. Date sampled: Month / Day / Year
 45. Date analyzed: Month / Day / Year

Latitude: 37.647299

Longitude: -87.507169


Lat/Long Method: INT GPS SUR REP

Date Received

48. Lithologic Log MW-9

From depth (ft)	To depth (ft)	Description
0.0	1.5	Clay dark brown trace grass and roots
1.5	12.0	Clay yellowish brown moist
12.0	23.2	Clay brown wet
23.2	28.2	Sandy clay gray wet
28.2	28.5	Sandstone yellowish brown soft weathered
	28.5	Auger refusal
28.5	30.5	Sandstone yellowish brown soft weathered
30.5	33.2	Sandstone gray soft
33.2	34.8	Sandstone gray
34.8	36.6	Sandstone yellowish brown soft weathered
36.6	44.6	Sandstone gray
44.6	50.8	Shale and interbedded sandstone gray abundant carbonaceous laminations
50.8	53.6	Shale gray
53.6	56.3	Shale and interbedded sandstone gray
	56.3	TD


MONITORING WELL 8006-3936 (MW-9)

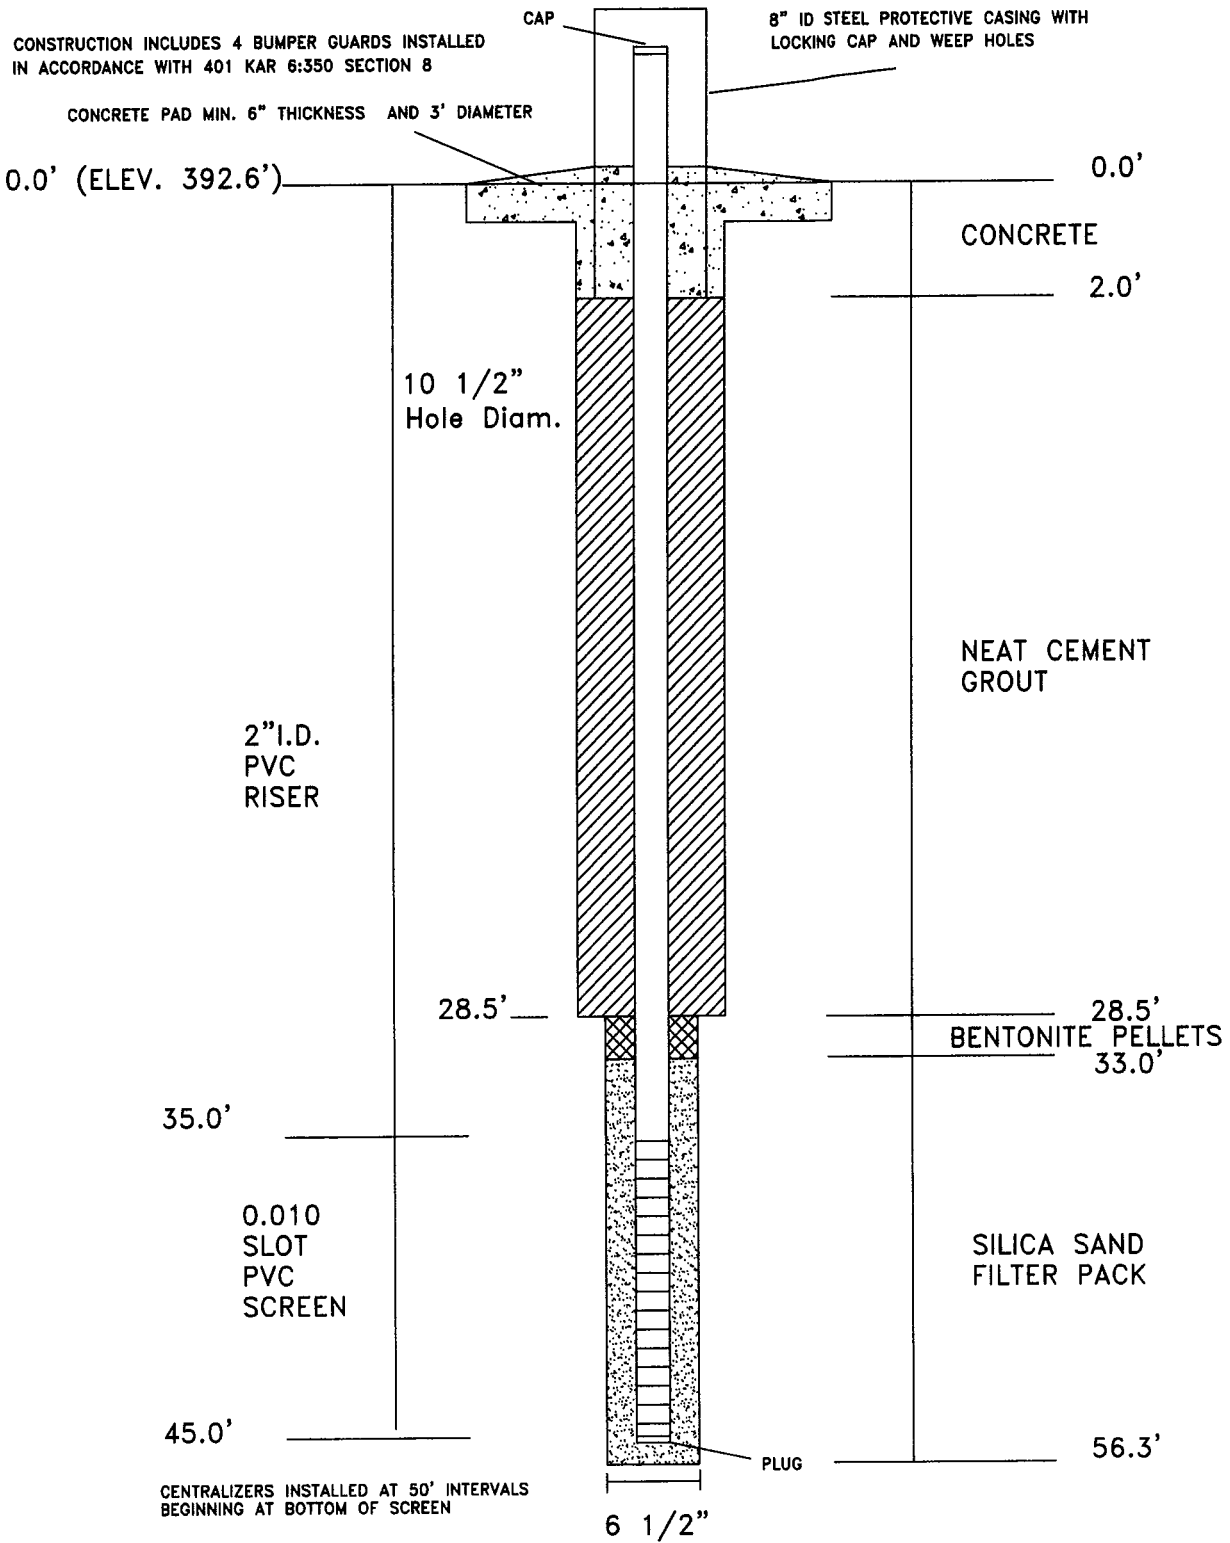

BIG RIVERS ELECTRIC CORPORATION

Well Construction Diagram

Job Number:	15-0140F	Revisions:
Date:	12/28/15	
Scale:	No Scale	
Drawn By:	D. Dunbar	

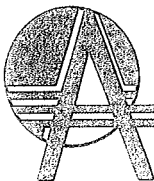

ASSOCIATED ENGINEERS, INC.

2740 North Main St. · Madisonville, KY 42431
 Phone: (270) 821-7732 · Fax: (270) 821-7789
 www.associatedengineers.com

UNIFORM KENTUCKY WELL CONSTRUCTION RECORD

Use this form only to report installation of monitoring or water wells.
 Original copy must be submitted to Division of Water within 60 days of completion.
 See instructions on reverse of form.
 Record must be typed or neatly printed or it will be returned to the driller as unacceptable.
 One copy to Division of Water, one copy to owner, one copy to driller's files.


8006-3937

4. Owner name Big Rivers Electric Corporation 5. Owner address 201 Third Street 6. City Henderson <small>If site name and address differ from owner name and address:</small> 9. Site name Sebree Station 10. Site address 9000 Highway 2096 11. City Robards		7. State KY 8. Zip 42420 12. State KY 13. Zip 42452		1. Kentucky Well ID (AKGWA) Number 8006 - 3937 2. Owner well ID# MW-10																																								
14. Agency Interest (AI) Number 4196		15. Facility type & ID Number <input type="checkbox"/> CERCLA <input type="checkbox"/> Solid Waste <input type="checkbox"/> Drinking Water <input type="checkbox"/> RCRA <input type="checkbox"/> UST <input type="checkbox"/> Mining CCR Rule		3. Attachments Required 1. Site plan or sketch map <input checked="" type="checkbox"/> 2. Well location On topographic map, OR <input checked="" type="checkbox"/> Obtained by GPS unit <input type="checkbox"/> Conditionally Required 3. Well diagram (monitoring well) <input checked="" type="checkbox"/> 4. Coliform analysis (if applicable) <input type="checkbox"/> 5. Signed Variance (if applicable) <input checked="" type="checkbox"/> Optional 6. Other laboratory analysis report <input type="checkbox"/>																																								
16. Owner phone 270 - 844 - 6031 17. Site phone 270 - 521 - 7927		23. Install start date 12 1 15 Month Day Year		24. Install end date 1 5 15 Month Day Year																																								
18. USGS topo map Robards 19. County Webster		21. Surface elevation (ft) 419.98 22. Elevation determined by <input type="checkbox"/> GPS <input type="checkbox"/> Map <input type="checkbox"/> Prior report <input checked="" type="checkbox"/> Survey <input type="checkbox"/> Prior well log		Please report depths in feet below ground surface, not as relative elevations. 25. Total depth 80.0 26. Depth to bedrock 28.5 27. Static water level 29.28 28. Casing height above surface (in) 29.88																																								
20. Physiographic Region <input type="checkbox"/> Blue Grass <input type="checkbox"/> Ohio River Alluvium <input type="checkbox"/> E. Coal Field <input checked="" type="checkbox"/> W. Coal Field <input type="checkbox"/> Miss. Plateau <input type="checkbox"/> Jackson Purchase		29. Well use <input type="checkbox"/> Agriculture <input type="checkbox"/> Geothermal <input type="checkbox"/> Commercial <input type="checkbox"/> Heat pump <input type="checkbox"/> Domestic <input type="checkbox"/> HVAC <input type="checkbox"/> Industrial <input type="checkbox"/> Injection <input checked="" type="checkbox"/> Monitoring / Remed 01 <input type="checkbox"/> Mining <input type="checkbox"/> Public <input type="checkbox"/> Unused		30. Drilling method <input type="checkbox"/> Auger - HS <input type="checkbox"/> Jet wash <input type="checkbox"/> Auger - SS <input type="checkbox"/> Push/probe <input type="checkbox"/> Auger - bucket <input type="checkbox"/> Rotary - air <input type="checkbox"/> Auger - hand <input type="checkbox"/> Rotary - mud <input type="checkbox"/> Cable tool <input type="checkbox"/> Rotary - reverse <input type="checkbox"/> Core <input type="checkbox"/> Sand point <input type="checkbox"/> Driven Casing <input type="checkbox"/> Sonic <input type="checkbox"/> Excavation <input type="checkbox"/> Unknown <input checked="" type="checkbox"/> Combined - HS auger and air rotary <input type="checkbox"/> Combined - other (specify):																																								
NOTE: CODE REQUIRED for most well uses. See back of form for codes.		31. Well status <input checked="" type="checkbox"/> Active <input type="checkbox"/> Inactive <input type="checkbox"/> Unsuitable for intended use		32. Wellhead <input type="checkbox"/> Flush <input type="checkbox"/> Well cap <input checked="" type="checkbox"/> Locking <input type="checkbox"/> Sanitary seal																																								
46. Well completion: Casing and screens <table border="1" style="width:100%; border-collapse: collapse;"> <thead> <tr> <th>From depth (feet)</th> <th>To depth (feet)</th> <th>Borehole diameter (inches)</th> <th>Casing diam (in) ID OD</th> <th>Casing type</th> <th>Screen slot size</th> </tr> </thead> <tbody> <tr> <td>0.0</td> <td>29.4</td> <td>10.5</td> <td>2.0 2.38</td> <td>Sch 40 PVC</td> <td></td> </tr> <tr> <td>29.4</td> <td>69.5</td> <td>6.5</td> <td>2.0 2.38</td> <td>Sch 40 PVC</td> <td></td> </tr> <tr> <td>69.5</td> <td>79.5</td> <td>6.5</td> <td>2.0 2.38</td> <td>Sch 40 Screen</td> <td>0.010</td> </tr> </tbody> </table>		From depth (feet)	To depth (feet)	Borehole diameter (inches)	Casing diam (in) ID OD	Casing type	Screen slot size	0.0	29.4	10.5	2.0 2.38	Sch 40 PVC		29.4	69.5	6.5	2.0 2.38	Sch 40 PVC		69.5	79.5	6.5	2.0 2.38	Sch 40 Screen	0.010	47. Annulus fill and seal <table border="1" style="width:100%; border-collapse: collapse;"> <thead> <tr> <th>From depth (feet)</th> <th>To depth (feet)</th> <th>Material</th> </tr> </thead> <tbody> <tr> <td>0.0</td> <td>2.0</td> <td>Concrete</td> </tr> <tr> <td>2.0</td> <td>63.5</td> <td>Cement grout</td> </tr> <tr> <td>63.5</td> <td>67.5</td> <td>Bentonite pellets</td> </tr> <tr> <td>67.5</td> <td>80.0</td> <td>Silica sand</td> </tr> </tbody> </table>		From depth (feet)	To depth (feet)	Material	0.0	2.0	Concrete	2.0	63.5	Cement grout	63.5	67.5	Bentonite pellets	67.5	80.0	Silica sand	33. Well development method <input type="checkbox"/> Surging <input type="checkbox"/> Jetting <input type="checkbox"/> Pumping <input type="checkbox"/> Backwashing <input type="checkbox"/> Bailing <input type="checkbox"/> Compressed air <input checked="" type="checkbox"/> Combination of methods (specify): Air-lift pump and water flush	
From depth (feet)	To depth (feet)	Borehole diameter (inches)	Casing diam (in) ID OD	Casing type	Screen slot size																																							
0.0	29.4	10.5	2.0 2.38	Sch 40 PVC																																								
29.4	69.5	6.5	2.0 2.38	Sch 40 PVC																																								
69.5	79.5	6.5	2.0 2.38	Sch 40 Screen	0.010																																							
From depth (feet)	To depth (feet)	Material																																										
0.0	2.0	Concrete																																										
2.0	63.5	Cement grout																																										
63.5	67.5	Bentonite pellets																																										
67.5	80.0	Silica sand																																										
48. Lithologic log (if more space is needed, continue on separate page) <table border="1" style="width:100%; border-collapse: collapse;"> <thead> <tr> <th>From depth (ft)</th> <th>To depth (ft)</th> <th>Description (include any show of water and indicate apparent quality)</th> </tr> </thead> <tbody> <tr> <td></td> <td></td> <td>See attachment</td> </tr> </tbody> </table>		From depth (ft)	To depth (ft)	Description (include any show of water and indicate apparent quality)			See attachment	49. Sketch map See attachment		34. Estimated well yield <input type="checkbox"/> gpm <input type="checkbox"/> gph <input type="checkbox"/> gpd 35. Well service # of people served																																		
From depth (ft)	To depth (ft)	Description (include any show of water and indicate apparent quality)																																										
		See attachment																																										
50. Comments 4 1/4" ID HSA followed by 10 1/2" drag bit advanced to 29.4'. 8" ID PVC casing set to 29.4'. 6 1/2" tricone bit advanced to 80.0'. Silica sand set 79.5'-80.0'. 2" casing and screen set. Sand placed 67.5'-79.5'. Bentonite pellets set 63.5'-67.5'. After minimum 8 hour hydration time, cement grout set 29.4'-63.5' using tremie method. 8" casing pulled and grouting continued to 2'. Protective surface casing and pad installed after grout cured.		36. Disinfectant amount <input type="checkbox"/> oz <input type="checkbox"/> qt <input type="checkbox"/> cups <input type="checkbox"/> lb <input type="checkbox"/> gal 37. Type <input type="checkbox"/> Bleach <input type="checkbox"/> Hypochlorite		38. Pitless adapter installed <input type="checkbox"/> Yes <input type="checkbox"/> No 39. Pump installed: <input type="checkbox"/> Submersible <input type="checkbox"/> Jet <input type="checkbox"/> Bailer or bucket <input type="checkbox"/> Turbine <input type="checkbox"/> Hand <input type="checkbox"/> No pump																																								
51. Affirmation: The work described above was done under my supervision, and this report is true and correct to the best of my knowledge. Note: the driller is not responsible for natural groundwater quality or quantity encountered while drilling or completing this well.		40. Depth to intake (ft)		41. Apparent quality and odor APPEARANCE: <input type="checkbox"/> Clear <input type="checkbox"/> Cloudy <input type="checkbox"/> Muddy <input type="checkbox"/> Turbid ODOR: <input type="checkbox"/> none <input type="checkbox"/> slight <input type="checkbox"/> mod. <input type="checkbox"/> high <input type="checkbox"/> Iron <input type="checkbox"/> Sulfur <input type="checkbox"/> Salt																																								
Signature of certified driller: <i>[Signature]</i> Date signed: 5/25/16		42. Coliform test type <input type="checkbox"/> fecal <input type="checkbox"/> fecal and total 43. Coliform test results <input type="checkbox"/> 0 or <1.0 <input type="checkbox"/> TNTC <input type="checkbox"/> Confluent or # colonies per 100 mL		44. Date sampled Month Day Year																																								
Certification number: 0219-0364-00 Drilling company: Associated Engineers, Inc.		45. Date analyzed Month Day Year		44. Latitude 37.646374 45. Longitude -87.505864																																								
Signature of certified driller: <i>[Signature]</i> Date signed: 5/25/16		Lat/Long Method <input type="checkbox"/> INT <input type="checkbox"/> GPS <input checked="" type="checkbox"/> SUR <input type="checkbox"/> REP		Date Received																																								

48. Lithologic Log MW-10

From depth (ft)	To depth (ft)	Description
0.0	0.3	Dense graded aggregate
0.3	12.9	Silty clay yellowish brown
12.9	14.0	Silty clay brown moist
14.0	17.5	Sandy clay brown wet
17.5	28.5	Sandy clay yellowish brown wet
28.5	29.4	Shale gray soft
	29.4	Auger refusal
30.0	35.8	Shale gray soft
35.8	37.6	Sandstone gray
37.6	48.5	Shale and interbedded sandstone gray
48.5	52.3	Sandstone gray
52.3	54.5	Shale and interbedded sandstone gray
54.5	55.6	Shale gray
55.6	59.7	Shale gray soft
59.7	60.9	Shale and interbedded sandstone gray
60.9	64.6	Shale gray
64.6	65.6	Sandy shale gray
65.6	66.5	Sandstone gray
66.5	68.4	Shale and interbedded sandstone gray
68.4	79.4	Sandstone gray
79.4	80.0	Shale and interbedded sandstone gray
	80.0	TD

MONITORING WELL 8006-3937
(MW-10)

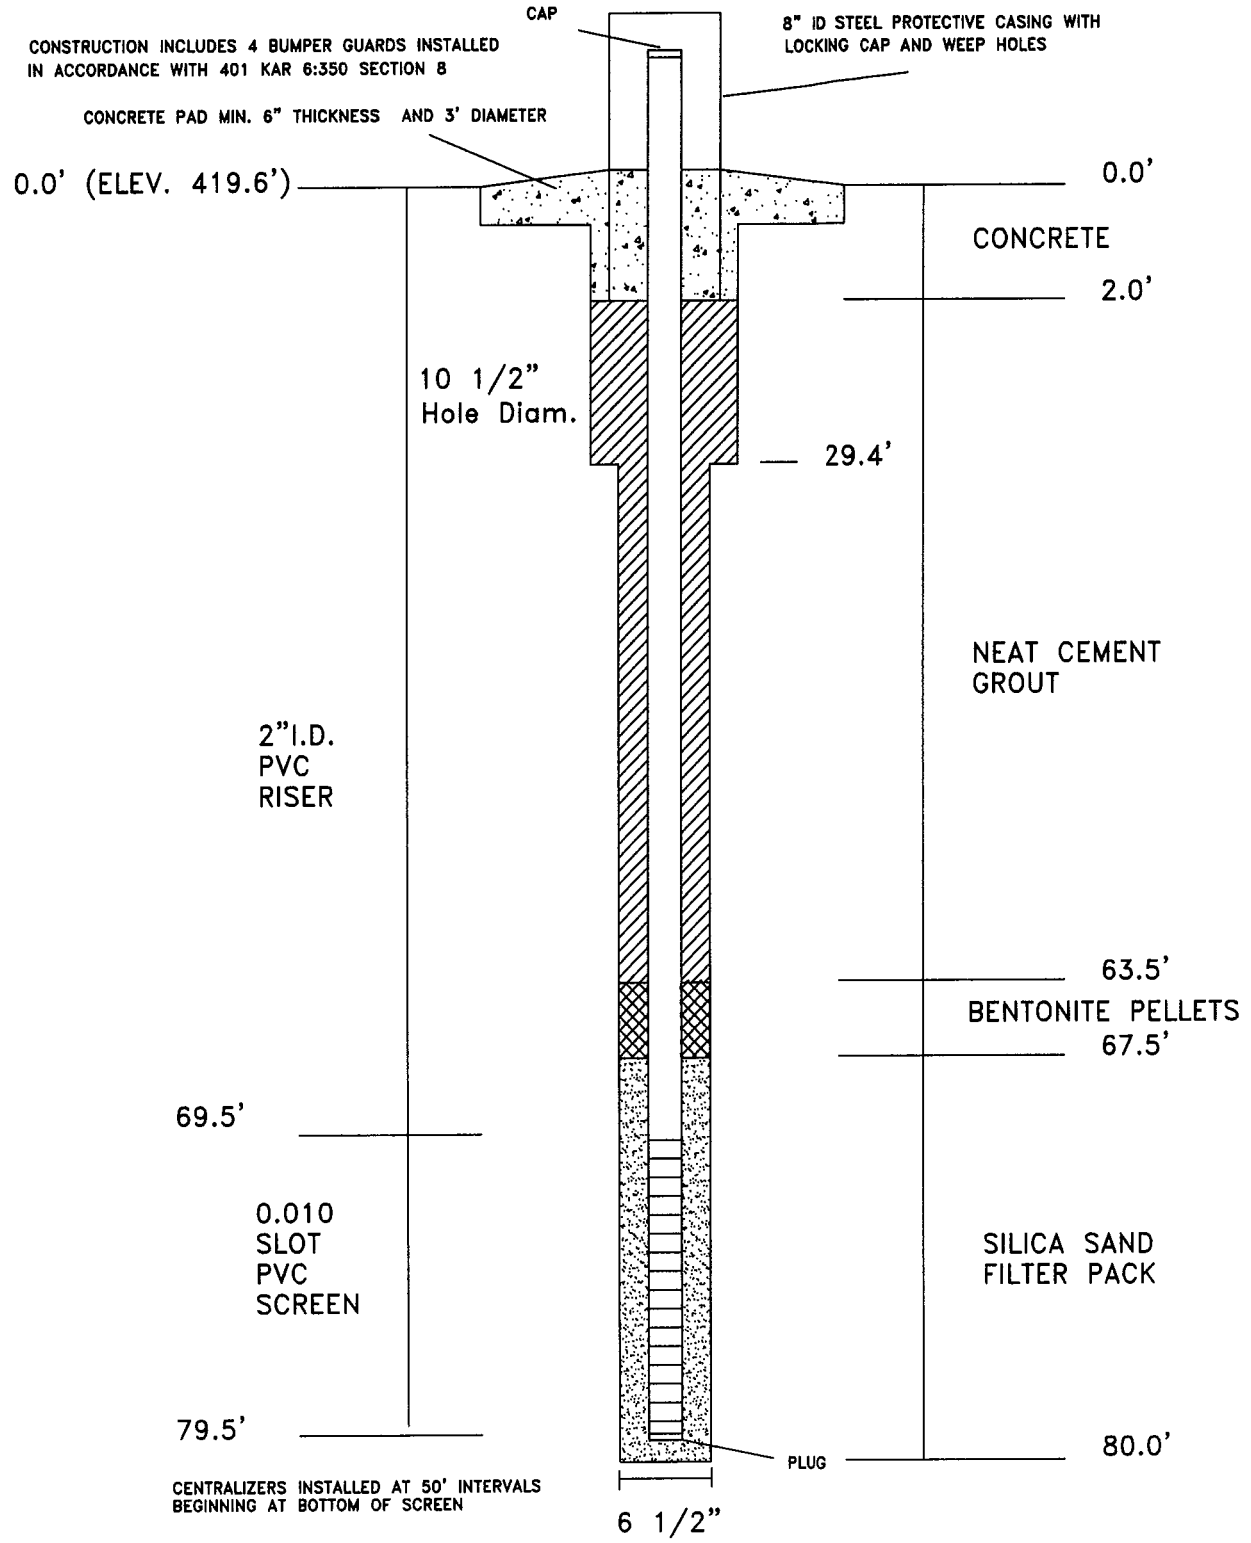

CENTRALIZERS INSTALLED AT 50' INTERVALS BEGINNING AT BOTTOM OF SCREEN



BIG RIVERS ELECTRIC CORPORATION

Well Construction Diagram

Job Number:	15-0140F	Revisions:
Date:	12/28/15	
Scale:	No Scale	
Drawn By:	D. Dunbar	

ASSOCIATED ENGINEERS, INC.

2740 North Main St. · Madisonville, KY 42431
Phone: (270) 821-7732 · Fax: (270) 821-7789
www.associatedengineers.com